

LEE MISSISSIPPI BOARD OF WATER COMMISSIONERS

L 57  
4-19-61

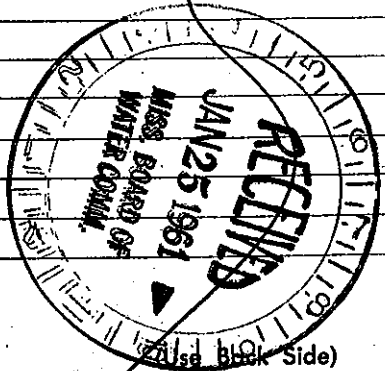
CODED

WATER WELL DRILLERS LOG

L 304

HERNDON WELL & SUPPLY CO.

Date: April 12, 1961, Driller: P. O. BOX 42 County, Lee  
SHANNON, MISSISSIPPI

(1) Owner of Land:	Description & Color of Materials Sand, Clay, Red Clay, Shell, etc.	Thick- ness Feet	Depth Feet
Howard Ratliff (Name) Rt 2 Tupelo, Miss (Address)	<del>Sustain sand &amp; clay to</del>	<del></del>	0
(2) Location: 1/4, 1/4, Sec. 15 T 10 S R 6 E 1 1/2 miles NE of Plantersville (distance) (direction) (Nearest Town)	<del>Blue shale to sand to</del>	<del></del>	19 198 200
(3) Topography: Hilly (Hilly) (Flat) (Level)	<del>to Bottom</del>	<del></del>	320
(4) Purpose of Well: Home use (Domestic Irrigation Municipal, Industrial, Other)	Sustain sand		0
Information upon completion of well:			
(1) Diameter 4 inches.	Sustain sand		0
(2) Total Depth 320 feet.	to Blue Rock		19
(3) Water Level 212 feet below top of ground.	to Hard Rock		199
(4) Cased to 20' 10" Size 4"	to Sand		200
(5) Screen: Size _____, Length _____	to Bottom		320
(6) Were any formations sealed against pollution? yes, no.	CODED		
If YES depth of formation 19'			
Why Sustain & sand			
Drillers Remarks:			
209			

Well No.