

LEE

L 58 CODED

7-17-62

MISSISSIPPI BOARD OF WATER COMMISSIONERS

WATER WELL DRILLERS LOG

Date: July 17, 1962, Driller: HERNDON WELL & SUPPLY CO. P.O. BOX 42 County Lee SHANNON, MISSISSIPPI

(1) Owner of Land:	Description & Color of Materials Sand, Clay, Red Clay, Shell, etc.	Thick- ness Feet	Depth Feet
Willie Hathcock (Name) Plattsville, Miss (Address)	Surface sand & clay		0
(2) Location: 1/4, 1/4, Sec 17 T 105 R 6E miles, of Plattsville (distance) (direction) (Nearest Town)	Blue sand & sand	18	200
(3) Topography: Flat (Hilly) (Flat) (Level)			
(4) Purpose of Well: Domestic (Domestic Irrigation Municipal, Industrial, Other)	Bottom	300	

Information upon completion of well:

- (1) Diameter 4 inches.
- (2) Total Depth 300 feet.
- (3) Water Level 20 feet below top of ground.
- (4) Cased to 21', Size 4"
- (5) Screen: Size —, Length —
- (6) Were any formations sealed against pollution?
yes, no.


If YES depth of formation 18 ft.

Why Surface & sand

Drillers Remarks:

216

CODED

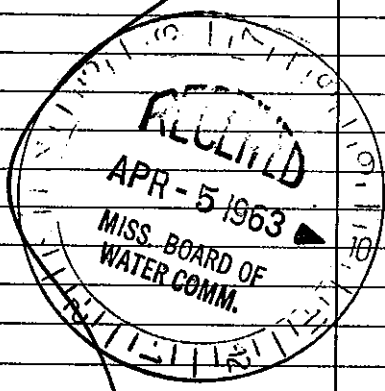

(Use Back Side)

Well No.