

LEE
L 59

MISSISSIPPI BOARD OF WATER COMMISSIONERS

8-27-62 CODED

WATER WELL DRILLERS LOG

HERNDON WELL & SUPPLY CO.

Date Aug 27, 1962, Driller: HERNDON WELL & SUPPLY CO.
P. O. BOX 42 County Lee
SHANNON, MISSISSIPPI

(1) Owner of Land	Description & Color of Materials Sand, Clay, Red Clay, Shell, etc.	Thick- ness Feet	Depth Feet
<u>Reva McCormick</u> (Name) <u>Plantersville, Miss</u> (Address)	<u>Surface sand</u> & clay		<u>0</u> <u>30</u>
(2) Location: <u>1/4</u> , <u>1/4</u> , Sec. <u>16</u> T. <u>105</u> R. <u>6E</u> <u>1</u> miles <u>W</u> of <u>Plantersville</u> (distance) (direction) (Nearest Town)	<u>Blue sand</u> & <u>sand</u>		<u>180</u>
(3) Topography: <u>Flat</u> (Hilly) (Flat) (Level)	<u>Bottom</u>		<u>300</u>
(4) Purpose of Well: <u>Domestic</u> (Domestic Irrigation Municipal, Industrial, Other)			

Information upon completion of well:


- (1) Diameter 4 inches.
- (2) Total Depth 300 feet.
- (3) Water Level 85 feet below top of ground.
- (4) Cased to 40', Size 4".
- (5) Screen: Size , Length .
- (6) Were any formations sealed against pollution?
 yes, no.

If YES depth of formation 30'

Why Surface & sand

Drillers Remarks:

CODED

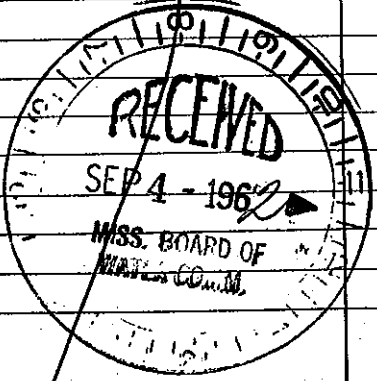

(Use Back Side)

Well No.

217

Mail this copy to Board of Water Commissioners 429 Miss. St. Jackson, Miss