

LEE MISSISSIPPI BOARD OF WATER COMMISSIONERS

L62

10-4-63

CODED

WATER WELL DRILLERS LOG

Date: 10/9, 1963, Driller: _____ County Lee

(Name) MISSISSIPPI

(1) Owner of Land:	Description & Color of Materials Sand, Clay, Red Clay, Shell, etc.	Thick- ness Feet	Depth Feet
(Name) Pete Sullivan (Contractor) Nettleton, Miss. (Address)	surface sand & clay		0
(2) Location: 1/4, 1/4, Sec. 27, T. 10 N., R. 12 E. 2 1/2 miles SE of Phloxville (distance) (direction) (Nearest Town)	Blue rock	5	25
(3) Topography: Hilly (Hilly) (Flat) (Level)	Sand	5	180
(4) Purpose of Well: Domestic (Domestic Irrigation Municipal, Industrial, Other)	Bottom		300

Information upon completion of well:

- (1) Diameter 4 inches.
- (2) Total Depth 300 feet.
- (3) Water Level 70 feet below top of ground.
- (4) Cased to 27', Size 44
- (5) Screen: Size —, Length —
- (6) Were any formations sealed against pollution?
 yes, no.


If YES depth of formation 25'

Why surface & sand

Drillers Remarks:

226

CODED

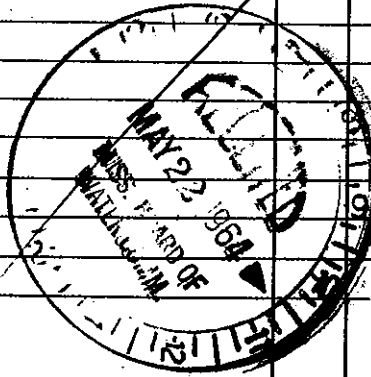

Well No.

(Use Back Side)

Mail this copy to Board of Water Commissioners, 429 Miss. St. Jackson, Miss.