

LEE MISSISSIPPI BOARD OF WATER COMMISSIONERS

L63

5-8-65

CODED

WATER WELL DRILLERS LOG

Herndon-Homan Well & Supply, Inc.


Date: May 8, 1965, Driller: SHANNON P. O. Box 42 County Lee  
(Name) MISSISSIPPI 38868

		Description & Color of Materials Sand, Clay, Red Clay, Shell, etc.	Thick- ness Feet	Depth Feet
(1) Owner of Land	<u>Charles C. Bowen</u> <small>(Name)</small>			
	<u>H1 Plattsville Miss.</u> <small>(Address)</small>	<u>sand + clay</u>	<u>0 - 18</u>	
(2) Location:	<u>1/4, 1/4, Sec. 11, T. 19 N., R. 6 E.</u>	<u>blue clay</u>	<u>18 - 240</u>	
	<u>2 miles NE, of Plattsville</u> <small>(distance) (direction) (Nearest Town)</small>	<u>Sand</u>	<u>240 - 360</u>	
(3) Topography:	<u>Hilly</u> <small>(Hilly) (Flat) (Level)</small>	<u>Bottom</u>	<u>360</u>	
(4) Purpose of Well:	<u>Domestic</u> <small>(Domestic Irrigation Municipal, Industrial, Other)</small>			

Information upon completion of well:

- (1) Diameter 4 inches.
  - (2) Total Depth 360 feet.
  - (3) Water Level 135' feet below top of ground.
  - (4) Cased to 20', Size 4"
  - (5) Screen: Size —, Length —
  - (6) Were any formations sealed against pollution?  
 yes,  no.
- If YES depth of formation 18'
- Why surface + sand
- Drillers Remarks:

CODED

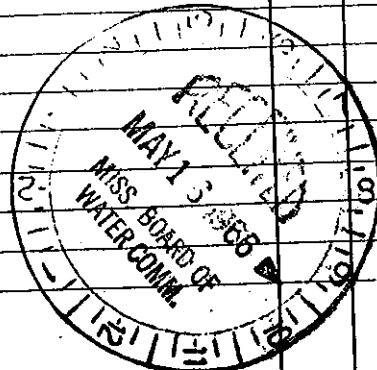

(Use Back Side)

Well No.

227