

LEE

MISSISSIPPI BOARD OF WATER COMMISSIONERS

L 64

7-21-65 CODED

WATER WELL DRILLERS LOG

Hendon-Homan Well & Supply, Inc.


Date July 21, 1965 Driller: P. O. Box 42 County Lee

SHANNON, MISSISSIPPI 38608

| | | Description & Color of Materials Sand, Clay, Red Clay, Shell, etc. | Thick- ness Feet | Depth Feet |
|----------------------|---|---|------------------------|---------------|
| (1) Owner of Land: | Brook's Building Co. (Name) | | | |
| (cont'd) | Nettleton, Miss. (Address) | surface mud clay | 0 | 38 |
| (2) Location: | 1/4, 1/4, Sec. 36 T. 10 S. R. 6 E. 6 miles N of Nettleton (distance) (direction) (Nearest Town) | blue clay | 34-180 | |
| (3) Topography: | Hilly (Hilly) (Flat) (Level) | sand | 180-300 | |
| (4) Purpose of Well: | Domestic (Domestic Irrigation Municipal, Industrial, Other) | Bottom | 300 | |

Information upon completion of well:

- (1) Diameter 4 inches.
- (2) Total Depth 300 feet.
- (3) Water Level 70' feet below top of ground.
- (4) Cased to 40', Size 4"
- (5) Screen: Size _____, Length _____
- (6) Were any formations sealed against pollution?
 yes, _____ no.
- If YES depth of formation 56'
- Why surface & sand
- Drillers Remarks:

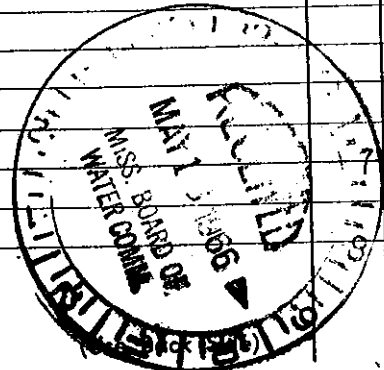

Well No.

229

Retain this copy for your office files.