

LEE
M 12
9-1-62

MISSISSIPPI BOARD OF WATER COMMISSIONERS

WATER WELL DRILLERS LOG

HERNDON WELL & SUPPLY CO.



Date: Sept 1, 1962, Driller: P. O. BOX 42 County Lee
Name: SHANNON MISSISSIPPI

(1) Owner of Land:	Description & Color of Materials Sand, Clay, Red Clay, Shell, etc.	Thick- ness Feet	Depth Feet
<u>Stewart Young</u> (Name) <u>231 Plantersville, Miss</u> (Address)	<u>surface sand & clay</u>		<u>0</u>
(2) Location: <u>1/4</u> , <u>1/4</u> , Sec. <u>19</u> T. <u>10 S</u> R. <u>7 E</u> <u>5</u> miles <u>E</u> , of <u>Plantersville</u> (distance) (direction) (Nearest Town)	<u>Blue earth</u>	<u>75</u>	<u>45</u>
(3) Topography: <u>Hilly</u> (Hilly) (Flat) (Level)	<u>sand</u>	<u>140</u>	
(4) Purpose of Well: <u>Domestic</u> (Domestic Irrigation Municipal, Industrial, Other)	<u>Bottom</u>	<u>300</u>	

Information upon completion of well:

- (1) Diameter 5 inches.
- (2) Total Depth 300 feet.
- (3) Water Level 100 feet below top of ground.
- (4) Cased to 45 ft, Size 5 in.
- (5) Screen: Size —, Length —.
- (6) Were any formations sealed against pollution?
 yes, no.

If YES depth of formation 45 ft.
Why surface & sand
Drillers Remarks: new brick

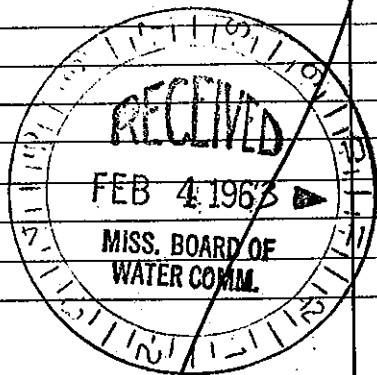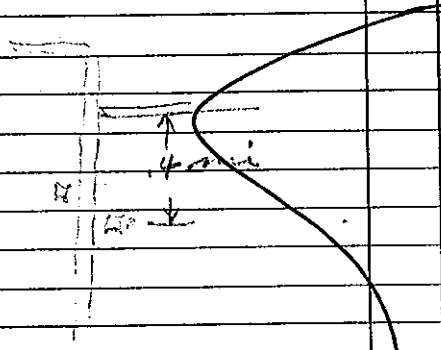

(Use Back Side)

Well No.

231 Elev 360