

Lee

34

M 13

9-66

MISSISSIPPI BOARD OF WATER COMMISSIONERS

WATER WELL DRILLERS LOG

Herndon-Homan Well & Supply, Inc.

Date: Sept. 3, 1966, Driller: P. O. Box 42 County Lee
(When well drilled) SHANNON, MISSISSIPPI 38868 (Where well is located)
HAROLD COBBIN (TENANT)

(1) Owner of Land:	Description & Color of Materials Sand, Clay, Red Clay, Shell, etc.	Thick- ness Feet	Depth Feet
<u>M B Partlow</u> (Name)	<u>Surface sand</u>	<u>30</u>	<u>30</u>
<u>Plantersville, Miss.</u> (Address)	<u>Black clay</u>	<u>80</u>	<u>110</u>
(2) Location: <u>NW 1/4 SE 1/4, Sec 29 T12R7</u>	<u>Ground</u>	<u>170</u>	<u>240</u>
<u>4 1/2</u> miles <u>EAST</u> , of <u>Plantersville</u> (distance) (direction) (Nearest Town)			
(3) Topography: <u>Hilly</u> (Hilly) (Flat) (Level)			
(4) Purpose of Well: <u>Domestic</u> (Domestic Irrigation Municipal, Industrial, Other)			

Information upon completion of well:

- (1) Diameter 4 inches.
- (2) Total Depth 240 feet.
- (3) Water Level _____ feet below top of ground.
- (4) Cased to 33' 2", Size 4"
- (5) Screen: Size None Length _____
- (6) Were any formations sealed against pollution?
 yes, no.

If YES depth of formation 30'


Why Surface & Sample

Drillers Remarks: _____

Yield in gpm: 3

Size pump: 3/4

Type power: Electric

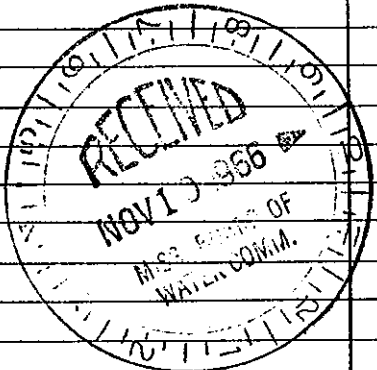

Mail this copy to Board of Water Commissioners 429 Miss. St. Jackson, Miss.

393 ELEV 345