

LEE
M 14
9-5-63

MISSISSIPPI BOARD OF WATER COMMISSIONERS

WATER WELL DRILLERS LOG

HERNDON WELL & SUPPLY CO.

Date: 9/5, 1963, Driller: P. O. BOX 42 County Lee
SHANNON MISSISSIPPI

(1) Owner of Land	Description & Color of Materials Sand, Clay, Red Clay, Shell, etc.	Thick- ness Feet	Depth Feet
<u>Rockwell Mfg. Co.</u> (Name) <u>Tupelo, Miss.</u> (Address)	<u>uniform sand</u> <u>+ clay</u>		<u>0</u>
(2) Location: <u>1/4</u> , <u>1/4</u> , Sec <u>5</u> <u>105</u> <u>3</u> miles <u>SW</u> of <u>Marshall</u> (distance) (direction) (Nearest Town)	<u>fine rock</u> <u>8</u> <u>hard</u>		<u>80</u> <u>260</u>
(3) Topography: <u>hilly</u> (Hilly) (Flat) (Level)	<u>0</u>		
(4) Purpose of Well: <u>Domestic</u> (Domestic Irrigation Municipal, Industrial, Other)	<u>Bottom</u>		<u>400</u>

Information upon completion of well:


- (1) Diameter 4 inches.
- (2) Total Depth 400 feet.
- (3) Water Level 145 feet below top of ground.
- (4) Cased to 281', Size 4"
- (5) Screen: Size , Length .
- (6) Were any formations sealed against pollution?
 yes, no.

If YES depth of formation cemented

Why uniform & hard

Drillers Remarks: using cement
full length

232 ELEV 380

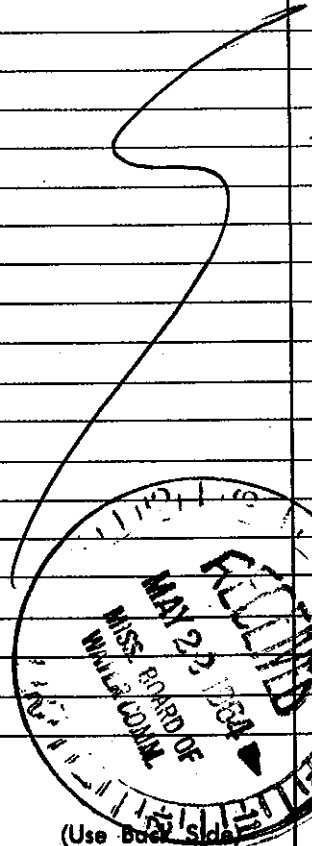

Well No.