

LEE  
 J M 15  
 7-3-62

MISSISSIPPI BOARD OF WATER COMMISSIONERS

WATER WELL DRILLERS LOG  
 HERNDON WELL & SUPPLY CO.



Date: July 3, 1962, Driller: P. O. BOX 42 County Lee  
SHANNON, MISSISSIPPI  
(Name)

(1) Owner of Land: <u>James Baines</u> <small>(Name)</small>	Description & Color of Materials Sand, Clay, Red Clay, Shell, etc.	Thick- ness Feet	Depth Feet
<u>Monrovia, Miss</u> <small>(Address)</small>	<u>Surface sand &amp; clay</u>		<u>0</u>
(2) Location: <u>32 35 10 TR 7E</u> <u>1</u> miles <u>W</u> of <u>Monrovia</u> <small>(distance) (direction) (Nearest Town)</small>	<u>Blue rock</u> <u>Sand</u>	<u>35</u> <u>0</u>	
(3) Topography: <u>Hilly</u> <small>(Hilly) (Flat) (Level)</small>	<u>0</u>		<u>180</u>
(4) Purpose of Well: <u>Domestic</u> <small>(Domestic Irrigation Municipal, Industrial, Other)</small>	<u>Bottom</u>		<u>300</u>

Information upon completion of well:

- (1) Diameter 4 inches.
- (2) Total Depth 300 feet.
- (3) Water Level 150 feet below top of ground.
- (4) Cased to 40', Size 4"
- (5) Screen: Size     , Length
- (6) Were any formations sealed against pollution?  
 yes,  no.

If YES depth of formation 35  
 Why Surface & Sand  
 Drillers Remarks: Behind store

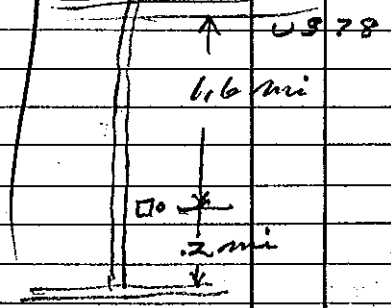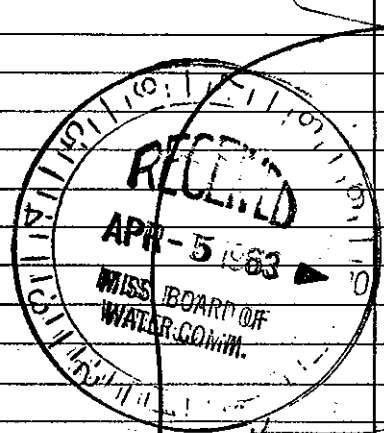

172 ELEV 420

(Use Back Side)

Well No.