

Lee

M 16
10-65

MISSISSIPPI BOARD OF WATER COMMISSIONERS

CODED

WATER WELL DRILLERS LOG

Herndon-Homan Well & Supply, Inc.

Date: Oct 2, 1965, Driller: R. O. Box 42 County Lee
(When well drilled) SHANNON, MISSISSIPPI 38868 (Where well is located)

(1) Owner of Land	Description & Color of Materials Sand, Clay, Red Clay, Shell, etc.	Thick- ness Feet	Depth Feet
<u>D. C. Bailey</u> (Name)	<u>surface sand</u>	<u>5</u>	<u>5</u>
<u>St 1 Plantersville Miss</u> (Address)	<u>2 clay</u>	<u>135</u>	<u>160</u>
(2) Location: <u>NE 1/4, NW 1/4, Sec. 19 T19R1E</u>	<u>Blue clay</u>	<u>135</u>	<u>160</u>
<u>4 miles E</u> of <u>Plantersville</u> (distance) (direction) (Nearest Town)	<u>sand</u>	<u>120</u>	<u>280</u>
(3) Topography: <u>hilly</u> (Hilly) (Flat) (Level)			
(4) Purpose of Well: <u>Domestic</u> (Domestic Irrigation Municipal, Industrial, Other)	<u>not connected to plot</u>		

Information upon completion of well:

- (1) Diameter 4 inches.
- (2) Total Depth 280 feet.
- (3) Water Level 110 feet below top of ground.
- (4) Cased to 25', Size 4"
- (5) Screen: Size none, Length _____.
- (6) Were any formations sealed against pollution?
 yes, no.

If YES depth of formation 25'

Why surface sand


Drillers Remarks: no pump installed

Yield in gpm: _____

Size pump: _____

Type power: _____

CODED

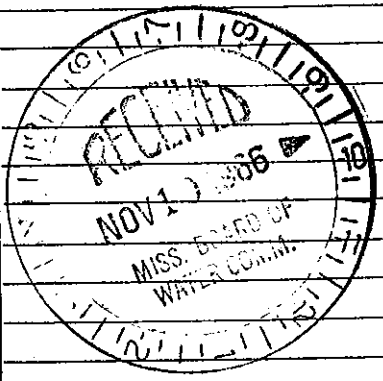

Mail this copy to Board of Water Commissioners 429 Miss. St. Jackson, Miss.

391