

CODED

Lee  
M 18  
4-67

MISSISSIPPI  
BOARD OF WATER COMMISSIONERS  
416 North State Street  
Jackson, Mississippi 39201

WATER WELL DRILLERS LOG  
Harndon-Homan Well & Supply, Inc.

Lee

4-27 1967  
date well completed

P. O. Box 42

SHANNON, MISSISSIPPI 38868

county well located

LANDOWNER:

description of formations encountered

from to

Moyad Estes  
Rt 1, Plantersville, Miss.  
(mailing address)

Surface sand  
& clay  
Blue clay  
Sand  
Bottom

0 38  
38 180  
180 300  
300

WELL LOCATION:


sec. 19 T. 10 N R. 7 E  
4 miles E of Plantersville  
(distance) (direction) (nearest town)

WELL PURPOSE: Home  
(home, irrigation, municipal, industrial)

WELL COMPLETION DATA:

- (1) diameter (inches) 5"
- (2) total depth (feet) 300'
- (3) static water level (feet) 116 below top of ground.
- (4) casing Steel 41'6" (material) (depth)  
5" (size) If telescope see back.
- (5) screen ND (length) (depth to top)  
(size) (material)
- (6) pump 3/4 (HP) 10 (yield gpm)  
electric (type power)
- (7) electric log ND (yes or no)  
(organization running log)
- (8) how well bottom plugged open

CODED

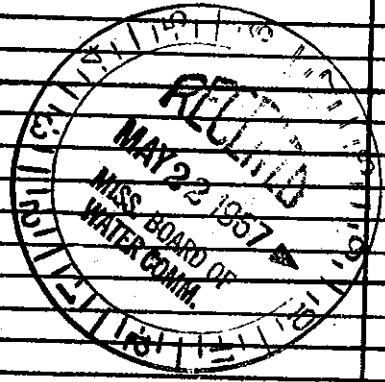

DRILLERS REMARKS: