

LEE MISSISSIPPI BOARD OF WATER COMMISSIONERS

M 19

6-15-65 CODED

WATER WELL DRILLERS LOG

Date: June 15, 1965, Driller: HERNDON WELLS & SUP. County Lee

(Name)

(1) Owner of Land: Crowford Hill
(Name)
M. Plantersville, Miss.
(Address)

(2) Location: 1/4, 1/4, Sec 30 T 10 S R 7 E
3 1/2 miles E, of Plantersville
(distance) (direction) (Nearest Town)

(3) Topography: Hilly
(Hilly) (Flat) (Level)

(4) Purpose of Well: Domestic
(Domestic Irrigation, Municipal, Industrial, Other)

Description & Color of Materials Sand, Clay, Red Clay, Shell, etc.	Thick- ness Feet	Depth Feet
<u>sand & clay</u>	<u>0-33</u>	
<u>Blue clay</u>	<u>33-180</u>	
<u>sand</u>	<u>180-300</u>	
<u>Bottom</u>	<u>300</u>	

Information upon completion of well:


- (1) Diameter 5 inches.
- (2) Total Depth 300 feet.
- (3) Water Level 103 feet below top of ground.
- (4) Cased to 35 1/2", Size 5 1/4"
- (5) Screen: Size —, Length —.
- (6) Were any formations sealed against pollution?
— yes, — no.

If YES depth of formation 33'
Why Mudstone & sand

Drillers Remarks:

234

CODED

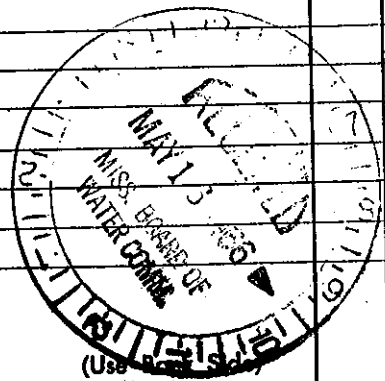

Well No.