

LEE

MISSISSIPPI BOARD OF WATER COMMISSIONERS

M 20

CODED

WATER WELL DRILLERS LOG

6-20-65

Date: Jan 20, 19 65, Driller: Herndon-Homan Well & Supply Co. See


P. O. Box 42  
SHANNON, MISSISSIPPI 38868

(1) Owner of Land:	Description & Color of Materials Sand, Clay, Red Clay, Shell, etc.	Thick- ness Feet	Depth Feet
<u>W.A. Morgan</u> (Name)	<u>sand &amp; clay</u>	<u>0 - 30</u>	<u>0 - 30</u>
<u>At 1 Plantersville, Miss</u> (Address)	<u>blue clay</u>	<u>30 - 140</u>	<u>30 - 140</u>
<u>10 1/2</u> (Distance)	<u>sand</u>	<u>140 - 300</u>	<u>140 - 300</u>
(2) Location: <u>1/4</u> , <u>1/4</u> , Sec. <u>2</u> , T. <u>R</u> 7E	<u>bottom</u>	<u>300</u>	<u>300</u>
(3) Topography: <u>3 1/2</u> miles <u>E</u> of <u>Plantersville</u> (distance) (direction) (Nearest Town)			
(4) Purpose of Well: <u>Domestic</u> (Domestic Irrigation, Municipal, Industrial, Other)			

Information upon completion of well:

- (1) Diameter 4 inches.
- (2) Total Depth 300 feet.
- (3) Water Level 105 feet below top of ground.
- (4) Cased to 34' 10", Size 4".
- (5) Screen: Size     , Length     .
- (6) Were any formations sealed against pollution?  
 yes,  no.
- If YES depth of formation 30'.
- Why surface & sand.
- Drillers Remarks:

CODED

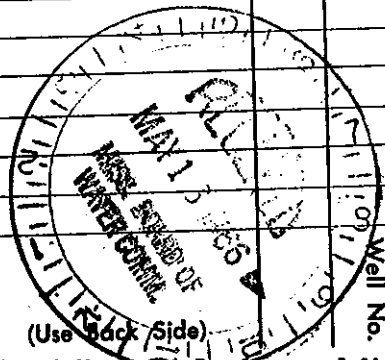

(Use back side)

Mail this copy to Board of Water Commissioners 429 Miss. St. Jackson, Miss.

235