

**LEE MISSISSIPPI BOARD OF WATER COMMISSIONERS**

M 21

6-11-65

CODED

**WATER WELL DRILLERS LOG**

Date: June 11, 1965, Driller: Herndon-Homan Well & Supply, Inc.  
P. O. Box #2 County Lee  
SHANNON, MISSISSIPPI 38868

	Description & Color of Materials Sand, Clay, Red Clay, Shell, etc.	Thick- ness Feet	Depth Feet
(1) Owner of Land: <u>Bro. Morgan</u> (Name) <u>Rt 1 Plantersville, Miss</u> (Address)	<u>sandy clay</u>	<u>0-28</u>	<u>28-180</u>
(2) Location: <u>1/4, 1/4, Sec 30</u> <u>3 1/2 miles E of Plantersville</u> (distance) (direction) (Nearest Town)	<u>sandy clay</u> <u>Bottom</u>	<u>180-300</u> <u>300</u>	
(3) Topography: <u>Hilly</u> (Hilly) (Flat) (Level)			
(4) Purpose of Well: <u>Domestic</u> (Domestic Irrigation Municipal, Industrial, Other)			

Information upon completion of well:


- (1) Diameter 5 inches.
- (2) Total Depth 300 feet.
- (3) Water Level 105' feet below top of ground.
- (4) Cased to 30' 8", Size 5"
- (5) Screen: Size     , Length
- (6) Were any formations sealed against pollution?  
✓ yes,      no.

If YES depth of formation 28'

Why surface & sand

Drillers Remarks:     

233

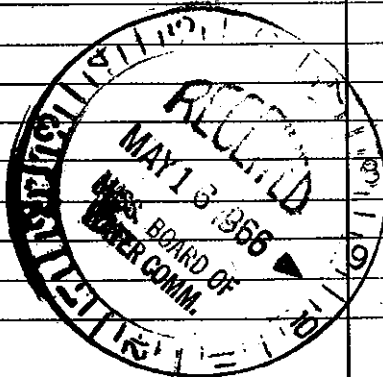

(Use Back Side)

Well No.