

MISSISSIPPI BOARD OF WATER COMMISSIONERS

WATER WELL DRILLERS LOG

Date: 7-21, 1960, Driller: Ewing Gools County Lee
(Name)

(1) Owner of Land: A.B. Ricks
(Name)
Wattston, Miss
(Address)

(2) Location: 1/4, 1/4, Sec. 30 T. R.
10S 7E
1/2 miles to of Wattston
(distance) (direction) (Nearest Town)

(3) Topography: Flat
(Hilly) (Flat) (Level)

(4) Purpose of Well: Domestic
(Domestic Irrigation, Municipal, Industrial, Other)

Description & Color of Materials Sand, Clay, Red Clay, Shell, etc.	Thick- ness Feet	Depth Feet
<u>Joint clay</u>	<u>0</u>	<u>20</u>
<u>Blue clay</u>	<u>20</u>	<u>90</u>
<u>Sand</u>	<u>90</u>	<u>206</u>

Information upon completion of well:

(1) Diameter 4 inches.

(2) Total Depth 206 feet.

(3) Water Level 45' feet below top of ground.

(4) Cased to 22', Size 4"


(5) Screen: Size _____, Length _____.

(6) Were any formations sealed against pollution?
 yes, _____ no.

If YES depth of formation 22'

Why _____

Drillers Remarks: _____

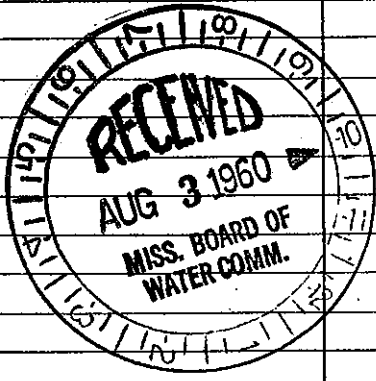

259

(Use Back Side)

Well No.