

CODED

CODED

Lee

N 16

2-67

Elec Log

MISSISSIPPI
BOARD OF WATER COMMISSIONERS
416 North State Street
Jackson, Mississippi 39201

WATER WELL DRILLERS LOG

date well completed Feb. 7 1967 Herndon-Homan Well & Supply, Inc. Lee
P. O. Box 42
county well located SHANNON, MISSISSIPPI 38868

LANDOWNER:

Tommy Dupree

P.O. Shannon Miss
(mailing address)

description of formations encountered

surface sand & clay
blue clay
sand
bottom

from

to

0 18
18 300
300 420
420

WELL LOCATION:



sec. 1 T. 11 N. R. 5 E.
S. W. 2 miles NE of Shannon
(distance) (direction) (nearest town)

WELL PURPOSE: Home
(home, irrigation, municipal, industrial)

WELL COMPLETION DATA:

- (1) diameter (inches) 5"
- (2) total depth (feet) 420'
- (3) static water level (feet) 65' below above top of ground.
- (4) casing Steel 22'
(material) (depth)
4"
(size) if telescope see back.
- (5) screen NO
(length) (depth to top)
(size) (material)
- (6) pump 1/2 5
(HP) (yield gpm)
electric
(type power)
- (7) electric log yes
(yes or no)
State Geological Sur.
(organization running log)
- (8) how well bottom plugged open

CODED

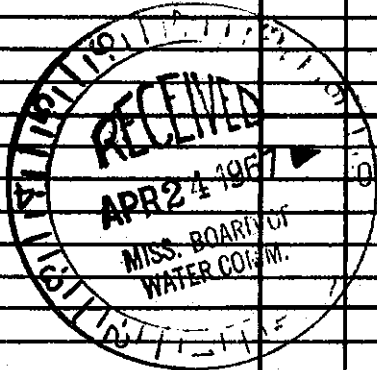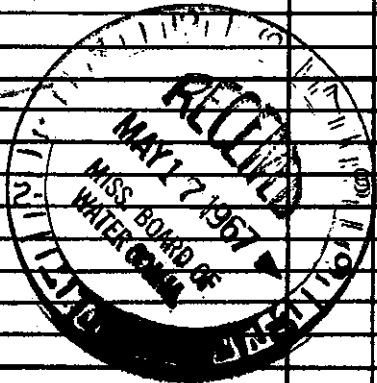

DRILLERS REMARKS: