

LEE  
N 17  
8-5-61

MISSISSIPPI BOARD OF WATER COMMISSIONERS

WATER WELL DRILLERS LOG

HERNDON WELL & SUPPLY CO. ~~1206~~

Date: Sept 5, 1961, Driller: P. O. BOX 42 County: Lee  
SHANNON, MISSISSIPPI



	Description & Color of Materials Sand, Clay, Red Clay, Shell, etc.	Thick- ness Feet	Depth Feet
(1) Owner of Land: <u>Ben Dewell</u> (Name) <u>Pt 1 Shannon, Miss.</u> (Address)	<u>Surface sand &amp; clay</u>		<u>0</u>
(2) Location: $\frac{1}{4}$ , $\frac{1}{4}$ , Sec. <u>2</u> T. <u>115</u> R. <u>6E</u> <u>2 1/2</u> miles <u>N</u> of <u>Shannon</u> , (distance) (direction) (Nearest Town)	<u>Shale</u> <u>sand</u>		<u>20</u> <u>340</u>
(3) Topography: <u>Hilly</u> (Hilly) (Flat) (Level)	<u>Bottom</u>		<u>460</u>
(4) Purpose of Well: <u>Domestic</u> (Domestic Irrigation Municipal, Industrial, Other)	<u>White fringe</u> <u>west side of road</u> <u>north of cemetery</u>		

Information upon completion of well:

- (1) Diameter 4 inches.
- (2) Total Depth 460 feet.
- (3) Water level 140' feet below top of ground.
- (4) Cased to 22', Size 4"
- (5) Screen: Size —, Length —
- (6) Were any formations sealed against pollution?  
✓ yes, — no.

If YES depth of formation 20  
Why Surface & sand  
Drillers Remarks: \_\_\_\_\_

244 ELEV 340

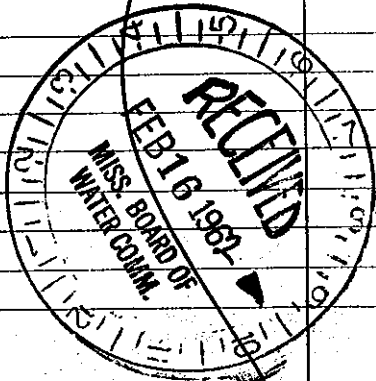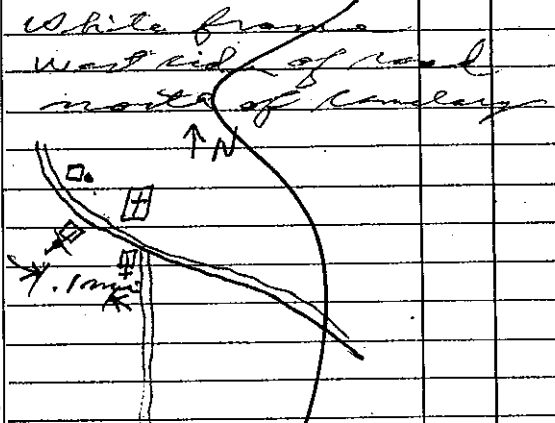

Well No. \_\_\_\_\_

(Use Back Side)