

LEE

MISSISSIPPI BOARD OF WATER COMMISSIONERS

N 18  
7-9-62

WATER WELL DRILLERS LOG

HERNDON WELL & SUPPLY CO.


Date: July 9, 1962, Driller: P. O. BOX 42 County Lee  
MEMPHIS, MISSISSIPPI

	Description & Color of Materials Sand, Clay, Red Clay, Shell, etc.	Thick- ness Feet	Depth Feet
(1) Owner of Land: Fisher Smith (Name) At 1 Shavers, Miss (Address)	Surface sand & clay		0
(2) Location: 1/4, 1/4, Sec. 26 113 E T R S F 4 miles SW of Shavers (distance) (direction) (Nearest Town)	Blue sand & sand		15  360
(3) Topography: Flat (Hilly) (Flat) (Level)			
(4) Purpose of Well: Domestic (Domestic Irrigation Municipal, Industrial, Other)	Bottom ↑ N		480

Information upon completion of well:

- (1) Diameter 4 inches.
- (2) Total Depth 480 feet.
- (3) Water Level 90 feet below top of ground.
- (4) Cased to 17' 8", Size 4
- (5) Screen: Size \_\_\_\_\_, Length \_\_\_\_\_
- (6) Were any formations sealed against pollution?  
yes, no.
- If YES depth of formation 15 ft.
- Why Surface & Sand
- Drillers Remarks:

247 ELEV 315

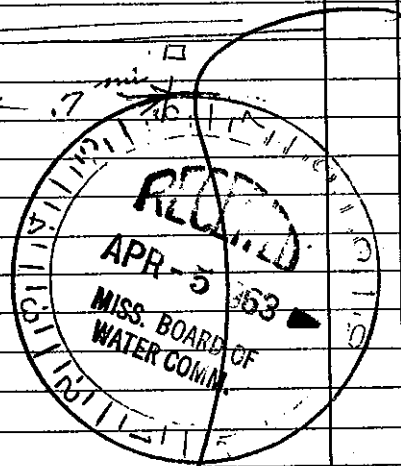

(Use Back Side)

Well No.