

LEE
N 19
7-23-02

MISSISSIPPI BOARD OF WATER COMMISSIONERS

WATER WELL DRILLERS LOG

HERNDON WELL & SUPPLY CO.

Date: July 23 1963 Driller:


P O BOX 42 County Lee
SEABOARD, MISSISSIPPI

| (1) Owner of Land: | (2) Location: | (3) Topography: | (4) Purpose of Well: | Description & Color of Materials Sand, Clay, Red Clay, Shell, etc. | Thick- ness Feet | Depth Feet |
|--------------------------------------|---|-----------------|----------------------|---|------------------------|---------------|
| H. W. Thompson Pt 2 Shawnee, Miss | 1/4, 1/4, Sec 26 T 11 S R 2 E 2 1/2 miles SW of Thomas | Flat | Domestic | Surface sand & clay | | 0 |
| | | | | Blue rock | | 20 |
| | | | | gravel | | 300 |
| | | | | Bottom | | 420 |

Information upon completion of well:

- (1) Diameter 4 inches.
- (2) Total Depth 420 feet.
- (3) Water Level 90 feet below top of ground. 78.7 3/21/67
- (4) Cased to 24", Size 4"
- (5) Screen: Size _____, Length _____
- (6) Were any formations sealed against pollution?
 yes, no.

If YES depth of formation 20'
Why Surface & gravel
Drillers Remarks:

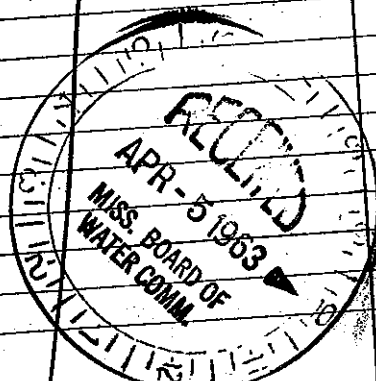

Well No.

(Use Back Side)

248 ELEV 282
Mail this copy to Board of Water Commissioners 429 Miss. St. Jackson, Miss