

LEE
N 20
10-27-62

MISSISSIPPI BOARD OF WATER COMMISSIONERS

WATER WELL DRILLERS LOG

HERNDON WELL & SUPPLY CO.



Date: Feb 27, 1962, Driller: SHANNON, P. O. BOX 42, County Lee, MISSISSIPPI

	Description & Color of Materials Sand, Clay, Red Clay, Shell, etc.	Thick- ness Feet	Depth Feet
(1) Owner of Land: <u>Terry Helms</u> (Name)	<u>Surface sand & clay</u>		0
(2) Location: <u>Shannon, Miss.</u> (Address)	<u>Blue sand</u>		20
(2) Location: <u>3/4, 1/4, Sec 34 T. 11 S. R. 2 E</u>	<u>Sandy</u>		340
(3) Topography: <u>3 miles SW of Shannon</u> (distance) (direction) (Nearest Town)	<u>Broken</u>		460
(3) Topography: <u>Flat</u> (Hilly) (Flat) (Level)	<u>Brown loam</u>		
(4) Purpose of Well: <u>Domestic</u> (Domestic Irrigation Municipal, Industrial, Other)	<u>↑ Brown loam</u>		

Information upon completion of well:

- (1) Diameter 4 inches.
- (2) Total Depth 460 feet. 100 3/20/67
- (3) Water Level 100 feet below top of ground.
- (4) Cased to 22' 3", Size 4"
- (5) Screen: Size —, Length —
- (6) Were any formations sealed against pollution?
 yes, no.

If YES depth of formation 20 ft.
Why Surface & sand
Drillers Remarks:

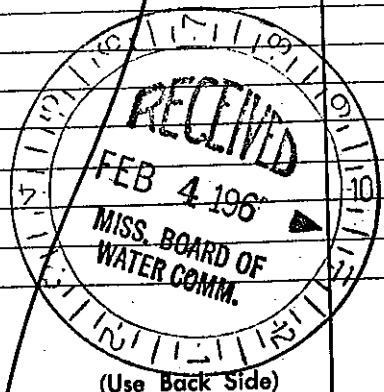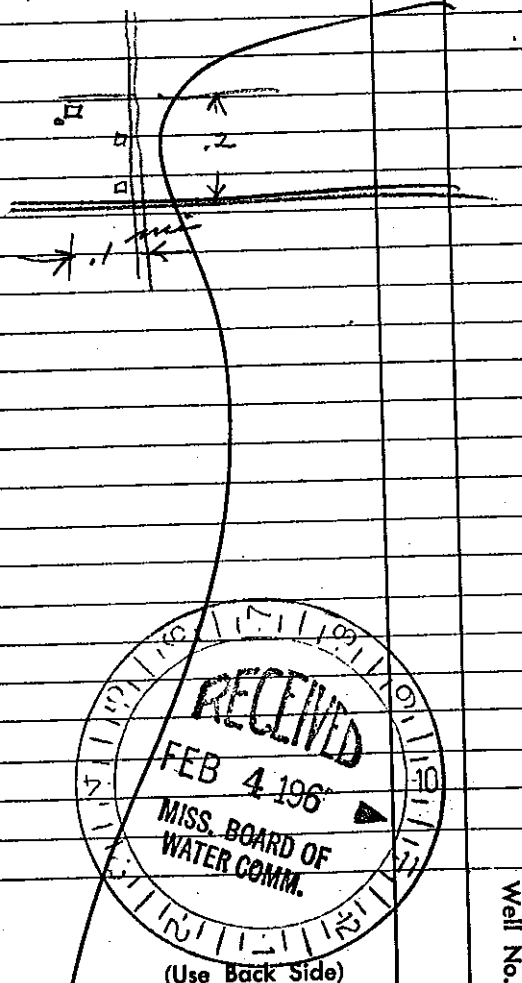

649 ELEV 320

Well No.