

MISSISSIPPI BOARD OF WATER COMMISSIONERS

WATER WELL DRILLERS LOG
HERNDON WELL & SUPPLY CO.

LEE
N 21
1-8-63



Date: Jan 8, 1963, Driller: SHANNON P. O. BOX 42 County LEE
(Name) MISSISSIPPI

	Description & Color of Materials Sand, Clay, Red Clay, Shell, etc.	Thick- ness Feet	Depth Feet
(1) Owner of Land: <u>Shannon Park</u> <small>(Name)</small> <u>Shannon, Min</u> <small>(Address)</small>	surface sand & clay		0
(2) Location: $\frac{1}{4}$, $\frac{1}{4}$, Sec <u>25</u> T <u>11S</u> R <u>2E</u> <u>1 1/2</u> miles <u>South</u> , of <u>Shannon</u> <small>(distance)</small> <small>(direction)</small> <small>(Nearest Town)</small>	Blue rock sand		28 300
(3) Topography: <u>FLR</u> <small>(Hilly)</small> <small>(Flat)</small> <small>(Level)</small>			
(4) Purpose of Well: <u>Domestic</u> <small>(Domestic Irrigation Municipal, Industrial, Other)</small>	Bottom		420

Information upon completion of well:

- (1) Diameter 5 inches.
- (2) Total Depth 420 feet.
- (3) Water Level 70 feet below top of ground. 177 3/20 67
- (4) Cased to 30 5", Size 5"
- (5) Screen: Size , Length
- (6) Were any formations sealed against pollution?
yes, no.

If YES depth of formation 28
Why surface road
Drillers Remarks:

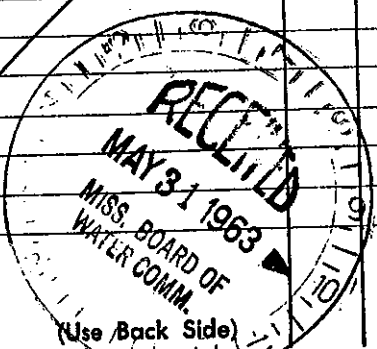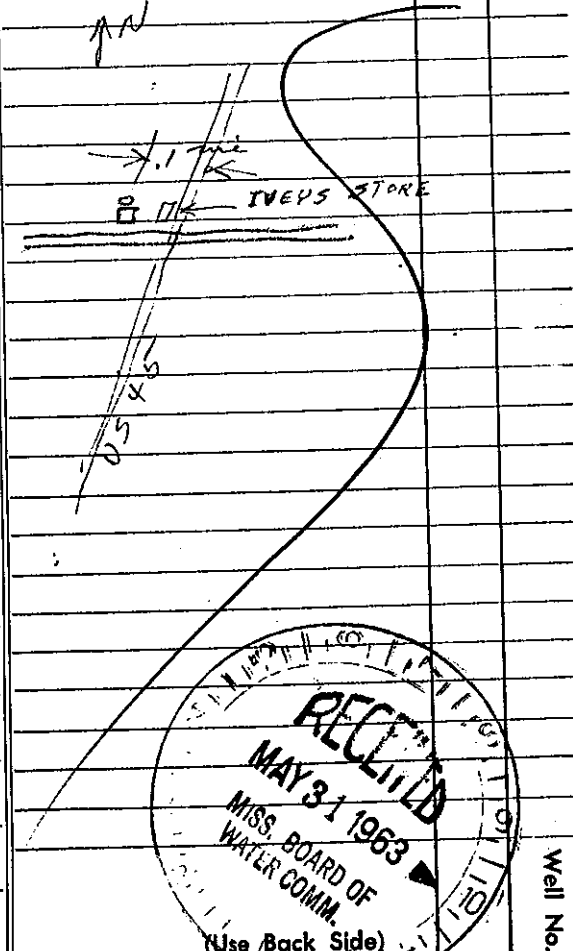

Well No.

Mail this copy to Board of Water Commissioners 429 Miss. St. Jackson, Miss

250 ELED 278