

MISSISSIPPI BOARD OF WATER COMMISSIONERS

WATER WELL DRILLERS LOG

LEE  
N22  
2-1-63



HERNDON WELL & SUPPLY CO.

Date: Feb 1, 1963, Driller: Lynn  
P.O. BOX 42  
Name: SHANNON, MISSISSIPPI  
County: Lee

	Description & Color of Materials Sand, Clay, Red Clay, Shell, etc.	Thick- ness Feet	Depth Feet
(1) Owner of Land: <u>hyper McCoody</u> (Name) <u>At Shannon, Miss</u> (Address)	surface sand & clay		0
(2) Location: $\frac{1}{4}$ , $\frac{1}{4}$ , Sec <u>21 118 SE</u> T. R. S.	Blue rock	8	20
(3) Topography: <u>3 1/2</u> miles <u>West</u> of <u>Shannon</u> (distance) (direction) (Nearest Town)	sand	8	380
(4) Purpose of Well: <u>Flat</u> (Hilly) (Flat) (Level)	Bottom		500

Information upon completion of well:

- (1) Diameter 5 inches.
  - (2) Total Depth 500 feet.
  - (3) Water Level 100 feet below top of ground.
  - (4) Cased to 23' 5" Size 5"
  - (5) Screen: Size \_\_\_\_\_, Length \_\_\_\_\_
  - (6) Were any formations sealed against pollution?  
 yes,  no.
- If YES depth of formation 20 ft
- Why surface & sand
- Drillers Remarks:

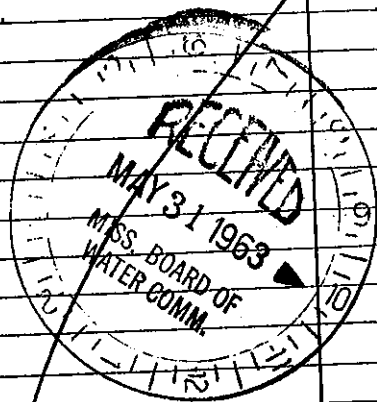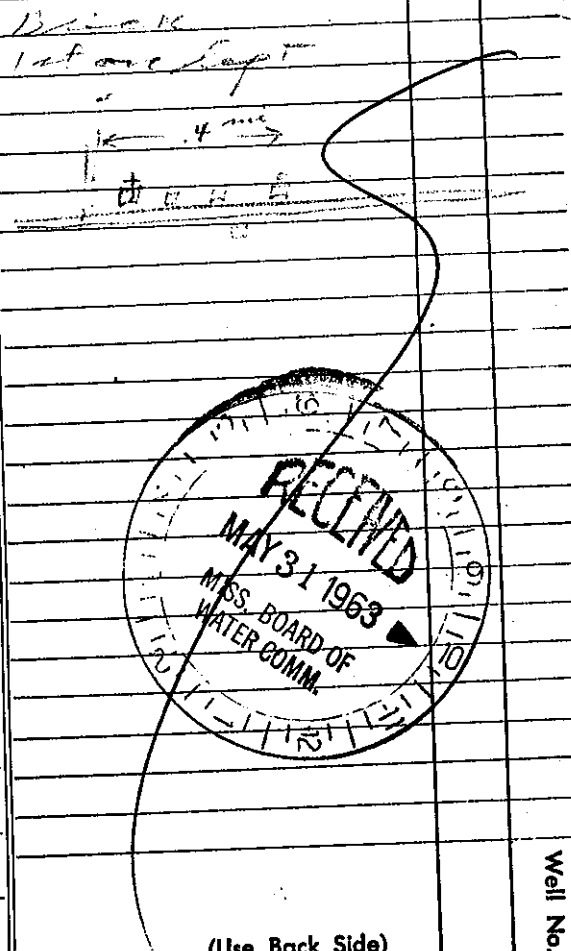

251 ELEV 300

(Use Back Side)

Well No.

Mail this copy to Board of Water Commissioners 429 Miss. St. Jackson, Miss