

LEE
N 23
7-7-60

MISSISSIPPI BOARD OF WATER COMMISSIONERS

WATER WELL DRILLERS LOG
Herndon Well & Supply Co. ~~1301~~
SHANNON, MISS.

Date: July 7, 1960 Driller: _____ County: Lee

	Description & Color of Materials Sand, Clay, Red Clay, Shell, etc.	Thick- ness Feet	Depth Feet
(1) Owner of Land: David Robbins (Name)	Sand & Clay		21
Shannon, Mississippi (Address)	Blue Rock		21
(2) Location: 1/4, 1/4, Sec 26 T11R5	Sand		300
1/2 miles S.W. of Shannon (distance) (direction) (Nearest Town)	Bottom		420
(3) Topography: Flat (Hilly) (Flat) (Level)			
(4) Purpose of Well: Home Use (Domestic Irrigation Municipal, Industrial, Other)			

Information upon completion of well:


- (1) Diameter 4 inches.
- (2) Total Depth 420 feet.
- (3) Water Level 70 feet below top of ground.
- (4) Cased to 21 ft, Size 4"
- (5) Screen: Size _____, Length _____
- (6) Were any formations sealed against pollution?
 yes, no.

If YES depth of formation 21 ft

Why Surface

Drillers Remarks:

237 ELEV. 273

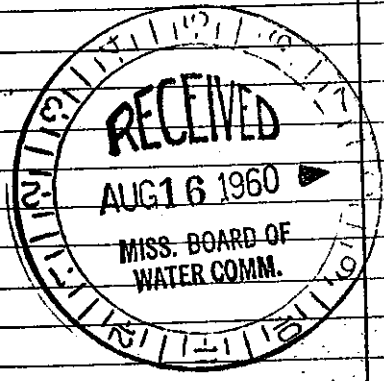

(Use Back Side)

Well No
1301

Mail this copy to Board of Water Commissioners 429 Miss. St. Jackson, Miss