

LEE

MISSISSIPPI BOARD OF WATER COMMISSIONERS

N 24


WATER WELL DRILLERS LOG

6-1-64

HERNDON WELL & SUPPLY CO.

Date: 6-1, 1964, Driller: SHANNON, Name MISSISSIPPI County Lee

	Description & Color of Materials Sand, Clay, Red Clay, Shell, etc.	Thick- ness Feet	Depth Feet
(1) Owner of Land: <u>Ann B. With</u> (Name) <u>At 1 Shannon, Miss.</u> (Address)	<u>surface sand</u> <u>and clay</u>		<u>0</u>
(2) Location: <u>1/4, 1/4, Sec 25 T. 15 R. 5 E</u> <u>2 miles SW</u> of <u>Thomas</u> (distance) (direction) (Nearest Town)	<u>of the rock</u>		<u>20</u>
(3) Topography: <u>flat</u> (Hilly) (Flat) (Level)	<u>ground</u>		<u>250</u>
(4) Purpose of Well: <u>Domestic</u> (Domestic Irrigation Municipal, Industrial, Other)	<u>to</u>		
Information upon completion of well:			
(1) Diameter <u>4</u> inches.	<u>Bottom</u> <u>250</u>		
(2) Total Depth <u>400</u> feet.	<u>100'</u>		
(3) Water Level <u>50</u> feet below top of ground.	<u>100'</u>		
(4) Cased to <u>23' 4"</u> , Size <u>4"</u>			
(5) Screen: Size <u>—</u> , Length <u>—</u>			
(6) Were any formations sealed against pollution? <input checked="" type="checkbox"/> yes, <input type="checkbox"/> no.			
If YES depth of formation <u>20'</u>			
Why <u>Surface &amp; Sand</u>			
Drillers Remarks:  <u>255 ELE 235</u>			

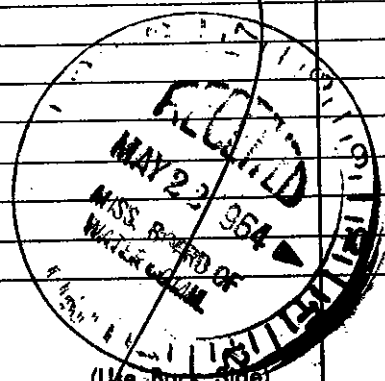

Well No.

(Use Back Side)

Mail this copy to Board of Water Commissioners 429 Miss. St. Jackson, Miss.