

LEE MISSISSIPPI BOARD OF WATER COMMISSIONERS

N 25  
5-13-65

WATER WELL DRILLERS LOG


Date: May 13, 1965 Driller: Herndon-Homan Well & Supply, Inc.  
P. O. Box 42 County Franklin  
**SHANNON, MISSISSIPPI 38668**

	Description & Color of Materials Sand, Clay, Red Clay, Shell, etc.	Thick- ness Feet	Depth Feet
(1) Owner of Land: <u>Bob Kyle</u> (Name) <u>Tupelo, Miss</u> (Address)	<u>sand &amp; clay</u>	<u>0-24</u>	<u>24-350</u>
(2) Location: <u>1/4, 1/4, Sec. 16 T. 11 S. R. 5 E</u> <u>4</u> miles <u>W</u> , of <u>Shannon</u> (distance) (direction) (Nearest Town)	<u>Blue clay</u> <u>Sand</u> <u>Bottom</u>	<u>350-500</u> <u>500</u>	
(3) Topography: <u>Hilly</u> (Hilly) (Flat) (Level)			
(4) Purpose of Well: <u>Cabin</u> (Domestic Irrigation Municipal, Industrial, Other)			

Information upon completion of well:

- (1) Diameter 4 inches.
- (2) Total Depth 500 feet.
- (3) Water Level 112' feet below top of ground.
- (4) Cased to 30', Size 4".
- (5) Screen: Size         , Length         .
- (6) Were any formations sealed against pollution?  
 yes,  no.

If YES depth of formation 24'  
Why surface sand  
Drillers Remarks:         

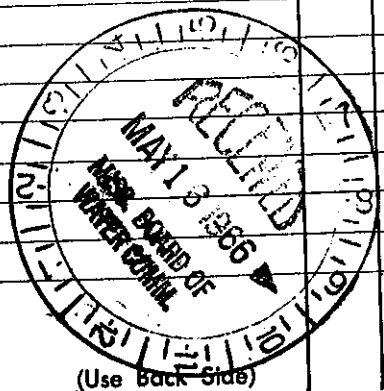

(Use back side)

Well No.

256