

WATER WELL DRILLERS LOG

LEE
N 26
8-30-60
Date: Aug 30, 1960, Driller: SHANNON, MISS. County: Lee

Herndon Well & Supply Co. ¹¹³⁰⁰


(Name)

(1) Owner of Land: Edward Filgo
(Name)
SHANNON Miss.
(Address)
(2) Location: 1/4, 1/4, Sec. 26 T11R5
2 miles S W of SHANNON
(distance) (direction) (Nearest Town)
(3) Topography: FLAT
(Hilly) (Flat) (Level)
(4) Purpose of Well: Home Use
(Domestic Irrigation
Municipal, Industrial, Other)

Description & Color of Materials Sand, Clay, Red Clay, Shell, etc.	Thick- ness Feet	Depth Feet
Surface Sand		
CLAY		16
Hard Rock		
Blue Rock		20
Hard Rock		180
Blue Rock		182
SAND		290
Bottom		420
Broken in National		
Energy sand		

Information upon completion of well:

(1) Diameter _____ inches.
(2) Total Depth 420 feet.
(3) Water Level 80 feet below top of ground.
(4) Cased to 21 ft, Size 4"
(5) Screen: Size _____, Length _____
(6) Were any formations sealed against pollution?
 yes, _____ no.
If YES depth of formation 20 ft
Why Surface & Sand
Drillers Remarks:
238 BLKV 273

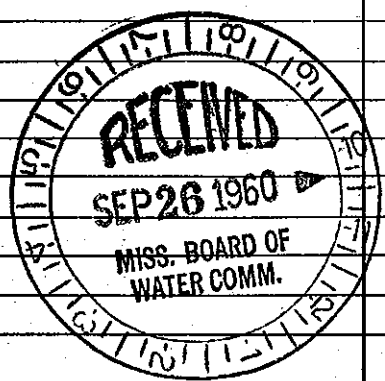

(Use Back Side)

Well No. 1300

Retain this copy for your office files.