

LEE
N 28
3-1-61

MISSISSIPPI BOARD OF WATER COMMISSIONERS

WATER WELL DRILLERS LOG
Herndon Well & Supply Co.
SHANNON, MISS.

N 28

Date: 3/1, 1961, Driller: _____ County Lee

(Name)

(1) Owner of Land: Ken Williams
(Name)

Rt 1 Shannon, Miss
(Address)

(2) Location: NW 1/4, SW 1/4, Sec 2 T. 115 R. 2E

5 miles NW of Shannon
(distance) (direction) (Nearest Town)

(3) Topography: Hill
(Hilly) (Flat) (Level)

(4) Purpose of Well: Home use
(Domestic Irrigation
Municipal, Industrial, Other)

Description & Color of Materials
Sand, Clay, Red Clay, Shell, etc:

Thick-
ness
Feet

Depth
Feet

SAND & clay 20

Blue shale 354

SAND

Bottom 480

4th on left 15 mi

of range house

11 1/2

white

from

black

shout

17

0

1

white

from

black

shout

Information upon completion of well:

(1) Diameter 4 inches.

(2) Total Depth 480 feet.

(3) Water Level 100' feet below top of ground.

(4) Cased to 21'6", Size 4"

(5) Screen: Size _____, Length _____

(6) Were any formations sealed against pollution?


yes, _____ no.

If YES depth of formation 20 ft

Why Surface & Sand

Drillers Remarks: _____

241 ELEV 315

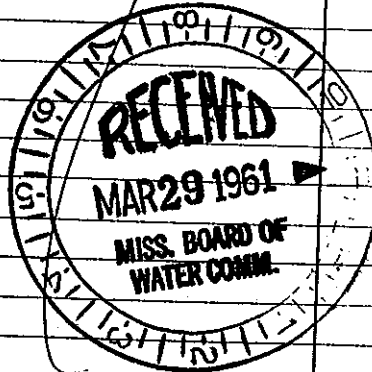

(Use Back Side)

Well No.

Mail this copy to Board of Water Commissioners 429 Miss. St. Jackson, Miss