

MISSISSIPPI BOARD OF WATER COMMISSIONERS

LEE
N 30
4-25-61

WATER WELL DRILLERS LOG

N 303

Date: April 25, 1961, Driller: HERNDON WELL & SUPPLY CO. County Lee
P. O. BOX 42
SHANNON, MISSISSIPPI



	Description & Color of Materials Sand, Clay, Red Clay, Shell, etc.	Thick- ness Feet	Depth Feet
(1) Owner of Land: <u>Mitchell Sisk</u> (Name) <u>Rt 1 Shannon, Miss</u> (Address)	<u>Surface sand & clay</u>	0	0
(2) Location: <u>1/4, 1/4, Sec. 2 T. 11 S. R. 2 E</u> <u>3</u> miles <u>N.W.</u> of <u>Shannon</u> , (Distance) (direction) (Nearest Town)	<u>Blue rock</u> <u>Sand</u>	20 360	20 360
(3) Topography: <u>Hilly</u> (Hilly) (Flat) (Level)	<u>Bottom</u>	480	480
(4) Purpose of Well: <u>Home use</u> (Domestic Irrigation Municipal, Industrial, Other)	<u>South of Brick</u> <u>South of factory</u>		

Information upon completion of well:

- (1) Diameter 4 inches.
 (2) Total Depth 480 feet.
 (3) Water Level 100 feet below top of ground.
 (4) Cased to 23' 4", Size 4"
 (5) Screen: Size , Length
 (6) Were any formations sealed against pollution?
 yes, no.

If YES depth of formation 20 ft
 Why surface & sand

Drillers Remarks:

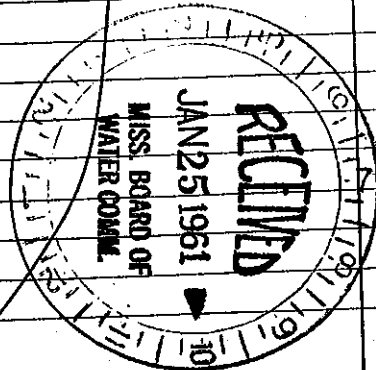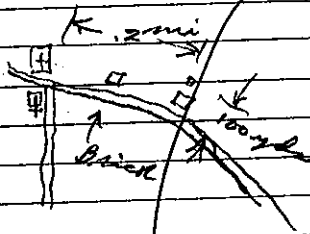

243 ELEV 335

(Use Back Side)

Well No.

Mail this copy to Board of Water Commissioners 429 Miss. St. Jackson, Miss.