

LEE WATER WELL DRILLERS L

LEE  
N 31  
Date: ~~7-10-62~~, 1962, Driller: Bones Foster County LEE  
(Name)

		Description & Color of Materials Sand, Clay, Red Clay, Shell, etc.	Thick- ness Feet	Depth Feet
(1) Owner of Land: <u>B M DABBS</u> (Name)		<u>yellow clay</u>	<u>30ft</u>	
<u>SHANNON</u> (Address)		<u>Blue Gyms</u>	<u>280ft</u>	
(2) Location: <u>1</u> / <u>4</u> , <u>115</u> / <u>4</u> , Sec. <u>8</u> T <u>10</u> R <u>5</u> <u>SE</u>		<u>sand</u>	<u>185ft</u>	
<u>2</u> miles <u>NW</u> , of <u>SHANNON</u> (distance) (direction) (Nearest Town)		<u>large white lenses</u>		
(3) Topography: <u>HILLY</u> (Hilly) (Flat) (Level)				
(4) Purpose of Well: (Domestic Irrigation Municipal, Industrial, Other)				


Information upon completion of well:

- (1) Diameter 4 inches.
- (2) Total Depth 495 feet.
- (3) Water Level 115 feet below top of ground.
- (4) Cased to 42 ft, Size 4"
- (5) Screen: Size \_\_\_\_\_, Length \_\_\_\_\_
- (6) Were any formations sealed against pollution?  
yes yes, \_\_\_\_\_ no.

If YES depth of formation 42 ft

Why to cool water off

Drillers Remarks: \_\_\_\_\_

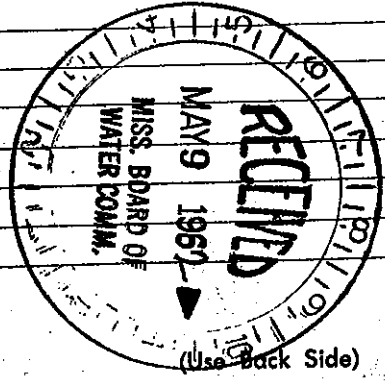

246 ELEV 322

Well No.