

LEE

N 33

WATER WELL DRILLERS LOG

Date: 8-4-60, Driller: Ewing Gasloc, Lee County, Lee

(Name)

(1) Owner of Land: JACK E. BRIDGE (Name)

SHANNON, MISS (Address)

(2) Location: 1/4, SE 1/4, Sec. 13, T11R5, S E Ten garage miles (distance) of (Nearest Town)

(3) Topography: (Hilly) (Flat) (Level)

(4) Purpose of Well: Household (Domestic Irrigation, Municipal, Industrial, Other)

Information upon completion of well:

(1) Diameter 4 inches.

(2) Total Depth 370 feet.

(3) Water Level 50 feet below top of ground.

(4) Cased to 21', Size 4"

(5) Screen: Size, Length

(6) Were any formations sealed against pollution? yes, no.

If YES depth of formation 21'

Why


Drillers Remarks:

260 ELB 260

Description & Color of Materials Sand, Clay, Red Clay, Shell, etc.

Thick-ness Feet

Depth Feet

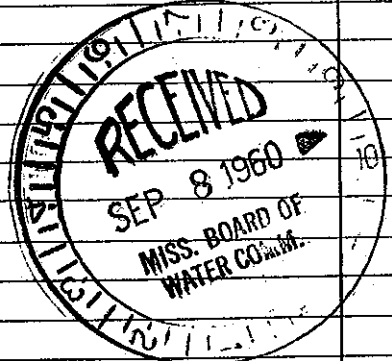

(Use Back Side)

Well No.