

Lee
N 35
12-66

MISSISSIPPI
BOARD OF WATER COMMISSIONERS
416 North State Street
Jackson, Mississippi 39201

WATER WELL DRILLERS LOG
Herndon-Homan Well & Supply, Inc. Lee
P. O. Box 42
SHANNON, MISSISSIPPI 38668 county well located

Dec 17 1966
date well completed

LANDOWNER:

Billy Hagedorn
P.O. Okolona Miss.
(mailing address)

description of formations encountered

description of formations encountered	from	to
surface soil & clay	0	12
Blue clay	12	380
Sand	380	500
Bottom	500	

WELL LOCATION:


sec. 34 T. 11 N. R. 5 E. S. 5
3 miles SW of Shannon
(distance) (direction) (nearest town)

WELL PURPOSE:

Home
(home, irrigation, municipal, industrial)

WELL COMPLETION DATA:

- (1) diameter (inches) 5"
- (2) total depth (feet) 500'
- (3) static water level (feet) 120' below top of ground.
- (4) casing Steel 16" (material) 16' (depth)
(size) If telescope see back.
- (5) screen NONE (length) (depth to top)
(size) (material)
- (6) pump 1/2 (HP) 5 (yield gpm)
Electric (type power)
- (7) electric log NO (yes or no)
(organization running log)
- (8) how well bottom plugged open

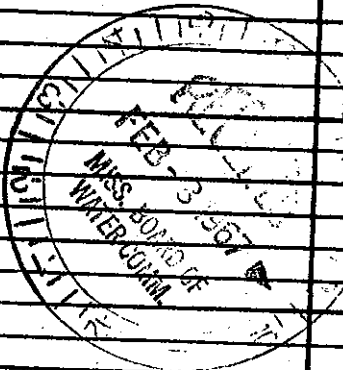

DRILLERS REMARKS:

398