

Lee
N36
9-66

MISSISSIPPI BOARD OF WATER COMMISSIONERS

WATER WELL DRILLERS LOG

Date: Sept. 17, 1966, Driller: Herndon-Homan Well & Supply Co. Lee
(When well drilled) P.O. Box 42 (Where well is located)
SPANNO, Miss.

(1) Owner of Land: Chick Miller
(Name)
Box 1 Shandon, Miss
(Address)
(2) Location: SE 1/4 NW 1/4, Sec 25 T11 R5
1 1/2 miles S/W of Shannon
(distance) (direction) (Nearest Town)
(3) Topography: Flat
(Hilly) (Flat) (Level)
(4) Purpose of Well: Domestic
(Domestic Irrigation
Municipal, Industrial, Other)

Description & Color of Materials Sand, Clay, Red Clay, Shell, etc.	Thick- ness Feet	Depth Feet
<u>surface sand & clay</u>	<u>25</u>	<u>25</u>
<u>Red clay</u>	<u>955</u>	<u>280</u>
<u>Sand</u>	<u>120</u>	<u>400</u>


300 yards of road

Information upon completion of well:

(1) Diameter 4 inches.
(2) Total Depth 400 feet.
(3) Water Level 8.5 feet below top of ground.
(4) Cased to 29', Size 4"
(5) Screen: Size NONE, Length _____
(6) Were any formations sealed against pollution?
✓ yes, _____ no.

If YES depth of formation 25'
Why surface & sand

Drillers Remarks:
Yield in gpm: 4
Size pump: 3/4
Type power: Electric

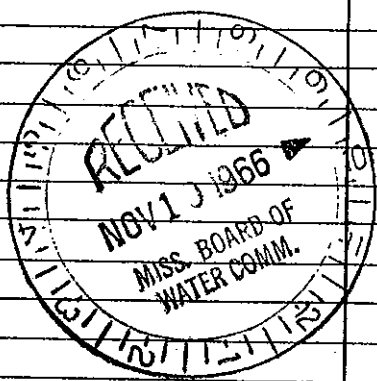

Mail this copy to Board of Water Commissioners 429 Miss. St. Jackson, Miss.
396 ILEV 298