

LEE

MISSISSIPPI BOARD OF WATER COMMISSIONERS

N 37

WATER WELL DRILLERS LOG

5-7-63

Date: 5/7, 1963, Driller: SHANNON WELL & SUPPLY CO.

SHANNON, MISSISSIPPI

County: Lee

(1) Owner of Land: George B. Bledsoe (Name)

Description & Color of Materials Sand, Clay, Red Clay, Shell, etc.

Thick-ness Feet

Depth Feet

Shannon, Miss. (Address)

surface sand & clay

0

(2) Location: 1/4, 1/4, Sec. 13, T. 11S, R. 5E

Shannon

20

1 miles (distance), of Shannon (Nearest Town)

(3) Topography: flat (Hilly) (Flat) (Level)

Sand

200

(4) Purpose of Well: Domestic (Domestic Irrigation, Municipal, Industrial, Other)

Bottom

400

Information upon completion of well:

(1) Diameter 4 inches.

(2) Total Depth 400 feet.

(3) Water Level 85 feet below top of ground.

(4) Cased to 22' 10", Size 4"

(5) Screen: Size, Length


(6) Were any formations sealed against pollution?

yes, no.

If YES depth of formation 20'

Why: surface & sand

Drillers Remarks:

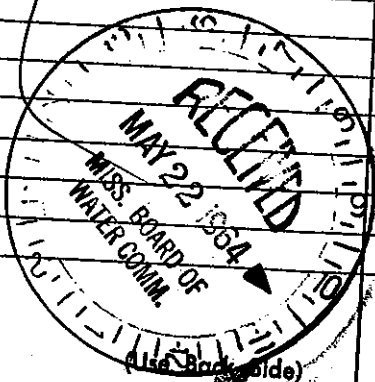

Well No.

253 ELEV 275

Mail this copy to Board of Water Commissioners 429 Miss. St. Jackson, Miss.