

Lee
N 40
10-66

CODED

MISSISSIPPI BOARD OF WATER COMMISSIONERS

WATER WELL DRILLERS LOG

Herndon-Homan Well & Supply, Inc.

Date: Oct. 5, 1966, Driller: P. O. Box 42 County Lee
(When well drilled) SHANNON, MISSISSIPPI 38808 (Where well is located)

(1) Owner of Land: <u>Frank Sisk</u> (Name)	Description & Color of Materials Sand, Clay, Red Clay, Shell, etc.	Thick- ness Feet	Depth Feet
<u>Qtz 2 Shannon, Miss.</u> (Address)	<u>surface sand</u>	<u>20</u>	<u>20</u>
(2) Location: <u>SE 1/4, NW 1/4, Sec 2 T11R5</u> , <u>2 1/2 miles NEU</u> of <u>Shannon</u> , (distance) (direction) (Nearest Town)	<u>280 Sand</u>	<u>280</u>	<u>300</u>
(3) Topography: <u>flat</u> (Hilly) (Flat) (Level)			
(4) Purpose of Well: <u>Domestic</u> (Domestic Irrigation Municipal, Industrial, Other)			

CODED

Information upon completion of well:

(1) Diameter 4 inches.

(2) Total Depth 440 feet.

(3) Water Level 195 feet below top of ground.

(4) Cased to 25', Size 4"

(5) Screen: Size NONE, Length _____

(6) Were any formations sealed against pollution?
 yes, _____ no.

If YES depth of formation 20'


Why None

Drillers Remarks: NONE

Yield in gpm: _____

Size pump: _____

Type power: _____

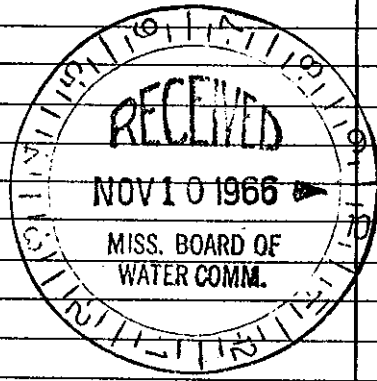

Mail this copy to Board of Water Commissioners 429 Miss. St. Jackson, Miss.

397