

LEE
N 43
8-67

MISSISSIPPI BOARD OF WATER COMMISSIONERS

WATER WELL DRILLERS LOG

Merndon-Homan Well & Supply, Inc.

Date: 8-1, 1967, Driller: P. O. Box 42 County Lee
(When well drilled) SHANNON, MISSISSIPPI 38588 (Where well is located)

		Description & Color of Materials Sand, Clay, Red Clay, Shell, etc.	Thick- ness Feet	Depth Feet
1) Owner of Land: <u>David Rollins</u> (Name)				
<u>Rt 1 Shannon, Miss.</u> (Address)		<u>surface sand & clay</u>		<u>0-16</u>
2) Location: <u>SW 1/4 SE 1/4, Sec. 35 T11 R 5E</u>		<u>blue clay</u>		<u>16-300</u>
<u>2 1/2</u> miles <u>SW</u> of <u>Shannon</u> (distance) (direction) (Nearest Town)		<u>sand</u>		<u>300-420</u>
3) Topography: <u>flat</u> (Hilly) (Flat) (Level)		<u>bottom</u>		<u>420</u>
4) Purpose of Well: <u>Home</u> (Domestic Irrigation, Municipal, Industrial, Other)				

Information upon completion of well:

(1) Diameter 5 inches.

(2) Total Depth 420 feet.

(3) Water Level 114 feet below top of ground.

(4) Cased to 21', Size 5".

(5) Screen: Size N/A, Length _____.

(6) Were any formations sealed against pollution?
 yes, no.

If YES depth of formation 16'


Why surface & sand

Drillers Remarks: _____

Yield in gpm: 5

Size pump: 1/2 HP sub.

Type power: electric

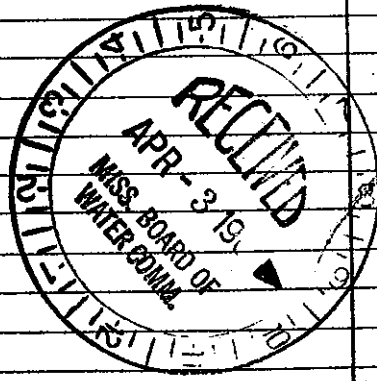

Mail this copy to Board of Water Commissioners 429 Miss. St. Jackson, Miss.