

CODED

MISSISSIPPI  
BOARD OF WATER COMMISSIONERS  
416 North State Street  
Jackson, Mississippi 39201

WATER WELL DRILLERS LOG

LEE  
N 44  
11-67

11/6/67 date well completed  
Harmon-Human Well & Supply, Inc. P.O. Box 12 Lee  
SHANNON, MISSISSIPPI 38801 county well located

LANDOWNER:  
Buddy Spence  
At Shannon Miss  
(mailing address)

description of formations encountered	from	to
surface sand		
& clay	0	18
blue clay	18	480
sand	480	600
below	600	


WELL LOCATION:  
sec 7 T 11 N R 5 E  
6 miles W of Shannon  
(distance) (direction) (nearest town)

WELL PURPOSE: Home  
(home, irrigation, municipal, industrial)

WELL COMPLETION DATA:

- diameter (inches) 5"
- total depth (feet) 600'
- static water level (feet) 150' below top of ground.
- casing Steel, 23 1/2" (material) (depth)  
If telescope see back.  
(size)
- screen NONE (length) (depth to top)  
(size) (material)
- pump 3/4 (HP) 5 (yield gpm)  
electric (type power)
- electric log YES (yes or no)  
USGS (organization running log)
- how well bottom plugged open

CODED

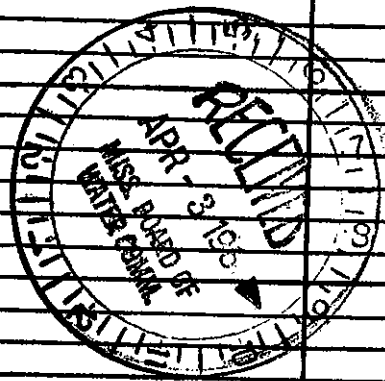

DRILLERS REMARKS: