

LEE
N 46
10-67

MISSISSIPPI
BOARD OF WATER COMMISSIONERS
416 North State Street
Jackson, Mississippi 39201

WATER WELL DRILLERS LOG

Lee
Irrigation-Homan Well & Supply, *Lee*
P. O. Box 42
~~Shannon, Mississippi 38848~~ county well located

10/27 19 67
date well completed

LANDOWNER:
Robert Clark
At 1 Shannon, Miss.
(mailing address)


description of formations encountered	from	to
<i>surface sand & clay</i>	<i>0</i>	<i>18</i>
<i>other clay</i>	<i>18</i>	<i>380</i>
<i>sand</i>	<i>380-500</i>	
<i>Bottom</i>	<i>500</i>	

WELL LOCATION:
sec *9* T. *11* S. R. *5* E.
4 miles *W* of *Shannon*
(distance) (direction) (nearest town)

WELL PURPOSE:
(home, irrigation, municipal, industrial)

- WELL COMPLETION DATA:
- (1) diameter (inches) *4"*
 - (2) total depth (feet) *500'*
 - (3) static water level (feet) *90'* below top of ground.
 - (4) casing *Steel, 22'9"*
(material) (depth)
 - _____ if telescope see back.
(size)
 - (5) screen *above*
(length) (depth to top)
 - 2"*
(size) (material)
 - (6) pump *3/4* *225 gph*
(HP) (yield gph)
 - electric*
(type power)
 - (7) electric log *no*
(yes or no)
 - _____ (organization running log)
 - (8) how well bottom plugged *open*

CODED

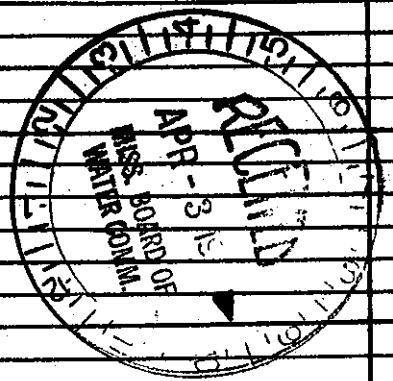

DRILLERS REMARKS: