

CODED

MISSISSIPPI BOARD OF WATER COMMISSIONERS  
416 North State Street  
Jackson, Mississippi 39201

WATER WELL DRILLERS LOG

Herndon-Homan Well & Supply, Inc.

P. O. Box 42

SHANNON, MISSISSIPPI 38668

LEE  
N48  
10-67

10/28/67  
date well completed

Lee  
county well located

LANDOWNER:

Old Union Baptist Church  
at Shannon Miss.  
(mailing address)

description of formations encountered

surface sand & clay  
blue clay  
sand  
Bedrock  
from 0 to 18  
18 to 340  
340 to 460  
460

WELL LOCATION:

sec. 2 T. 11 N. R. 5 E  
2 1/2 miles NW of Shannon  
(distance) (direction) (nearest town)


WELL PURPOSE:

Church  
(home, irrigation, municipal, industrial)

WELL COMPLETION DATA:

- (1) diameter (inches) 5"
- (2) total depth (feet) 460'
- (3) static water level (feet) 125' below top of ground.
- (4) casing steel 2 1/2" (material) (depth)  
(size) if telescope see back.
- (5) screen none (length) (depth to top)  
(size) (material)
- (6) pump 1/2 (HP) 5 (yield gpm)  
electric (type power)
- (7) electric log NO (yes or no)  
(organization running log)
- (8) how well bottom plugged open

CODED

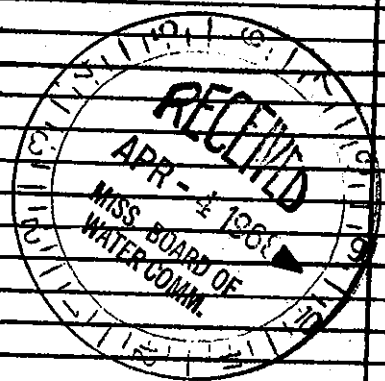

DRILLERS REMARKS: