

CODED

Lee
N 52
3-67

MISSISSIPPI
BOARD OF WATER COMMISSIONERS
416 North State Street
Jackson, Mississippi 39201

WATER WELL DRILLERS LOG
Herndon-Homan Well & Supply, Inc.

3-11 1967 date well completed P. O. Box 42 See
SHANNON, MISSISSIPPI 38868 county well located

LANDOWNER:

C. M. CLARK

RR 1 SHANNON MISS (mailing address)

description of formations encountered

Surface mud clay 0 18
Blue clay 18 400
Sand 400 520
Bottom 520

from to

WELL LOCATION:


sec 33 T 11 N R 5 E
S W
3 miles SW of SHANNON
(distance) (direction) (nearest town)

WELL PURPOSE: Home
(home, irrigation, municipal, industrial)

WELL COMPLETION DATA:

- (1) diameter (inches) 5
- (2) total depth (feet) 520
- (3) static water level (feet) 109 below above top of ground.
- (4) casing 5" (material) 22'6" (depth)
5" (size) If telescope see back.
- (5) screen NON P (length) (depth to top)
(size) (material)
- (6) pump 1/2 (HP) 5 (yield gpm)
electric (type power)
- (7) electric log NO (yes or no)
(organization running log)
- (8) how well bottom plugged NO

CODED

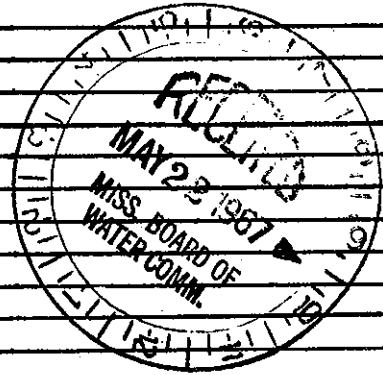

DRILLERS REMARKS: