

Lee
NS4
7-67

CODED

MISSISSIPPI BOARD OF WATER COMMISSIONERS

WATER WELL DRILLERS LOG

Herndon-Homan Well & Supply, Inc.

Date: 7-31, 1967, Driller: P. O. Box 42, County Lee
SHANNON, MISSISSIPPI 38868 (Where well is located)

1) Owner of Land: Sam Cape land
(Name)
At 1 Shannon, Miss.
(Address)
2) Location: SE 1/4, NW 1/4, Sec 26 T11R5E
2 1/2 miles SW of SHANNON
(distance) (direction) (Nearest Town)
3) Topography: flat
(Hilly) (Flat) (Level)
4) Purpose of Well: Home
(Domestic Irrigation
Municipal, Industrial, Other)


Description & Color of Materials Sand, Clay, Red Clay, Shell, etc.	Thick- ness Feet	Depth Feet
upper clay	0	20
blue clay	20	300
sand	300	420
bottom	420	

Information upon completion of well:

1) Diameter 5 inches.
2) Total Depth 420 feet.
3) Water Level 98' feet below top of ground.
4) Cased to 25', Size 5"
5) Screen: Size None, Length
6) Were any formations sealed against pollution?
yes, no.

CODED

YES depth of formation 20'
by surf sand
illers Remarks:
ield in gpm: 5
ize pump: 1/3 HP sub.
ype power: electric

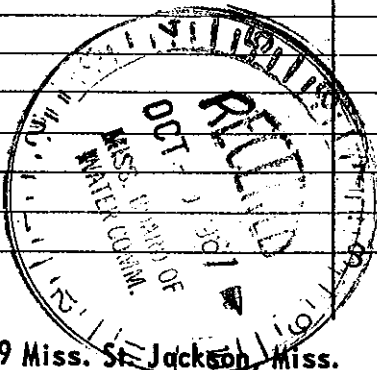

File this copy to Board of Water Commissioners 429 Miss. St. Jackson, Miss.