

Lee  
N 2002  
7-68

MISSISSIPPI  
BOARD OF WATER COMMISSIONERS  
416 North State Street  
Jackson, Mississippi 39201  
WATER WELL DRILLERS LOG

7-16-58 Herndon-Homan Well & Supply, Inc. Lee  
date well completed 1958 firm name county well located  
Shannon, Miss. Box 42


LANDOWNER:  
Bill Clark  
Shannon, Miss.  
(mailing address)

description of formation encountered	from	to
Surface Sand	0	18
Clay	18	300
Blue clay	300	420
Sand	420	420
Bottom		

WELL LOCATION:  
sec. 26 T. 11 N. R. 5 E  
2 miles SW of Shannon  
(distance) (direction) (nearest town)

WELL PURPOSE:  
Home  
(home, irrigation, municipal, industrial)

- WELL COMPLETION DATA:
- (1) diameter (inches) 5"
  - (2) total depth (feet) 420'
  - (3) static water level (feet) 102' below top of ground.
  - (4) casing (material) 21" 7.9' (depth)  
5.9" (size) If telescope see back.
  - (5) screen (length) (depth to top)  
(size) (material)
  - (6) pump 1/2 (HP) 5 (yield gpm)  
electric (type power)
  - (7) electric log (yes or no) NO  
(organization running log)
  - (8) how well bottom plugged open

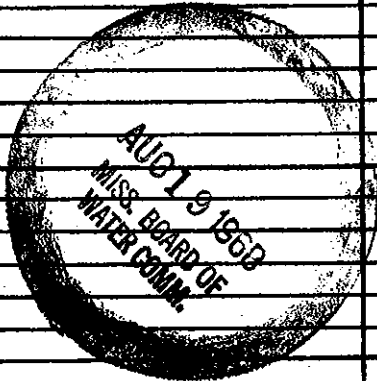

DRILLERS REMARKS: