

LEE

MISSISSIPPI BOARD OF WATER COMMISSIONERS

30

WATER WELL DRILLERS LOG

10-6-62

HERNDON WELL & SUPPLY CO.

Date Oct 6, 1962, Driller: P. O. BOX 42, County Lee

SHANNON, MISSISSIPPI

E. D. McEFFE

(1) Owner of Land	Description & Color of Materials Sand, Clay, Red Clay, Shell, etc.	Thick- ness Feet	Depth Feet
Town of Nettleton (Name)	sand & clay		0
Nettleton, Miss. (Address)			
(2) Location: 1/4, 1/4, Sec. 26 11 18 T. R. 66	Blue water		15
1/2 miles W of Nettleton (distance) (direction) (Nearest Town)	sand		60
(3) Topography: Flat (Hilly) (Flat) (Level)	Bottom		160
(4) Purpose of Well: Domestic (Domestic Irrigation, Municipal, Industrial, Other)			

Information upon completion of well:

- (1) Diameter 4 inches.
- (2) Total Depth 160 feet.
- (3) Water Level 40 feet below top of ground. (3.0 3/21/67)
- (4) Cased to 20', Size 4"
- (5) Screen: Size _____, Length _____
- (6) Were any formations sealed against pollution?
yes, no.


If YES depth of formation 15'

Why superior sand

Drillers Remarks: next to sewage

Lagoon - south side of lagoon

292 E. D. 222

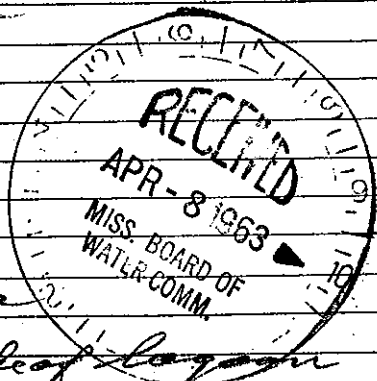

Well No.

(Use Back Side)

Mail this copy to Board of Water Commissioners 429 Miss. St. Jackson, Miss