

LEE

MISSISSIPPI BOARD OF WATER COMMISSIONERS

31

WATER WELL DRILLERS LOG

7-6-60

Herndon Well & Supply Co.

0300

Date: July 6, 1960, Driller: SHANNON, MISS. County Lee

(Name)

| (1) Owner of Land: | Description & Color of Materials Sand, Clay, Red Clay, Shell, etc. | Thick- ness Feet | Depth Feet |
|---|---|------------------------|---------------|
| Av. CH, Wiggan <small>(Name)</small> Nettleton, Mississippi <small>(Address)</small> | Sand & Clay | 5 | 21 |
| (2) Location: 1/4, 1/4, Sec. 13 T11 R6. | Blue Rock | 5 | 26 |
| 1/2 miles NORTH of NETTLETON <small>(distance) (direction) (Nearest Town)</small> | SAND | 5 | 40 |
| (3) Topography: Flat <small>(Hilly) (Flat) (Level)</small> | Bottom | 168 | |
| (4) Purpose of Well: Home use <small>(Domestic Irrigation, Municipal, Industrial, Other)</small> | AN | | |

Information upon completion of well:

(1) Diameter 4" inches.

(2) Total Depth 168 feet.

(3) Water Level _____ feet below top of ground.

(4) Cased to 21 ft Size 4"


(5) Screen: Size _____, Length _____

(6) Were any formations sealed against pollution?
 yes, _____ no.

If YES depth of formation 21 ft.
Why Surface

Drillers Remarks:

27 ELEV 295

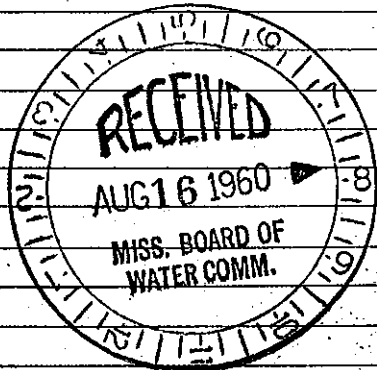

(Use Back Side)

Well No. 0300

Mail this copy to Board of Water Commissioners 429 Miss. St. Jackson, Miss