

LEE
 32
 2-15-62

MISSISSIPPI BOARD OF WATER COMMISSIONERS

WATER WELL DRILLERS LOG

HERNDON WELL & SUPPLY CO.

Date: 2-15, 1962, Driller: P.O. BOX 42 County, Lee
 SHANNON, MISSISSIPPI

(1) Owner of Land:	Description & Color of Materials Sand, Clay, Red Clay, Shell, etc.	Thick- ness Feet	Depth Feet
Richard T. Lee (Name)	Surface sand		0
At 2 Shannon (Address)	+ clay		
(2) Location: 1/4, 1/4, Sec. 21 N15E	White sand		17
2 miles East, of Shannon (distance) (direction) (Nearest Town)	Blue rock		28
(3) Topography: Flat (Hilly) (Flat) (Level)	Sand		250
(4) Purpose of Well: Domestic (Domestic Irrigation Municipal, Industrial, Other)	Bottom		320



Information upon completion of well:

- (1) Diameter 4 inches.
- (2) Total Depth 320 feet. 93.0 3/21/67
- (3) Water Level 50 feet below top of ground.
- (4) Cased to 33'5", Size 4"
- (5) Screen: Size _____, Length _____
- (6) Were any formations sealed against pollution?
 yes, no.

If YES depth of formation 28 ft

Why surface sand

Drillers Remarks:

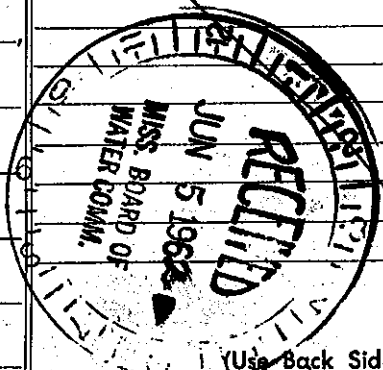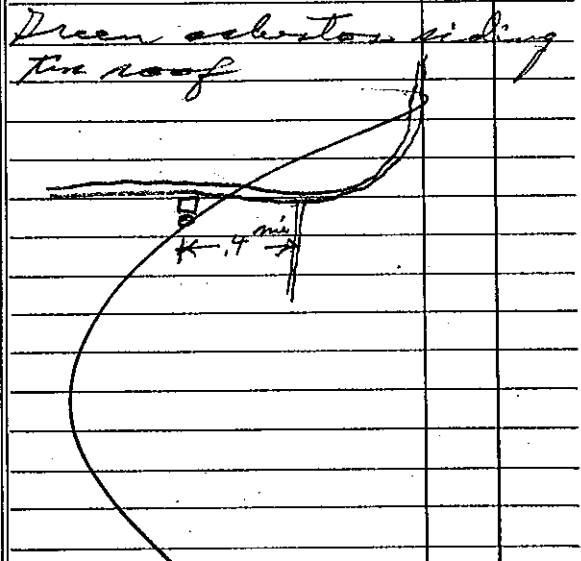

280 ELEV 282

Well No.

Mail this copy to Board of Water Commissioners 429 Miss. St. Jackson, Miss