

MISSISSIPPI BOARD OF WATER COMMISSIONERS

LEE

33

11-20-62

WATER WELL DRILLERS LOG

MERNDON WELL & SUPPLY CO.

Date, Nov. 20, 1962, Driller: P. O. BOX 42 County LEE

SHANNON, MISSISSIPPI

	Description & Color of Materials Sand, Clay, Red Clay, Shell, etc.	Thick- ness Feet	Depth Feet
(1) Owner of Land: <u>Ralph E. King</u> (Name)			
<u>402 Shannon, Miss.</u> (Address)	<u>surface sand & clay</u>		<u>0</u>
(2) Location: <u>1/4</u> , <u>1/4</u> , Sec. <u>4</u> T. <u>115</u> R. <u>6E</u>	<u>Blue silt</u>		<u>18</u>
<u>2 1/2</u> miles <u>NE</u> of <u>Shannon</u> (distance) (direction) (Nearest Town)	<u>sand</u>		<u>18 1/2</u>
(3) Topography: <u>Flat</u> (Hilly) (Flat) (Level)	<u>shell</u>		<u>280</u>
(4) Purpose of Well: <u>Domestic</u> (Domestic Irrigation Municipal, Industrial, Other)	<u>sand</u>		<u>265</u>
	<u>Bottom</u>		<u>340</u>


Information upon completion of well:

- (1) Diameter 4 inches.
- (2) Total Depth 340 feet.
41 3/2/67
- (3) Water Level 70 feet below top of ground.
- (4) Cased to 21'3", Size 4"
- (5) Screen: Size —, Length —
- (6) Were any formations sealed against pollution?
yes, no.

If YES depth of formation 18 ft.Why surface & sand

Drillers Remarks:

294 ELEV 265

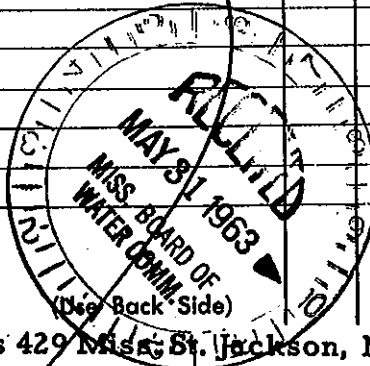

Well No.

Mail this copy to Board of Water Commissioners 429 Miss. St. Jackson, Miss.