

LEE MISSISSIPPI BOARD OF WATER COMMISSIONERS

034

10-31-65

WATER WELL DRILLERS LOG


Herndon-Homan Well & Supply, Inc.

Date: Oct 31, 1963, Driller: SHANNON, MISSISSIPPI 38868 P. O. Box 42 County Lee

	Description & Color of Materials Sand, Clay, Red Clay, Shell, etc.	Thick- ness Feet	Depth Feet
(1) Owner of Land: <u>Frank WATTS</u> (Name)	<u>sand + clay</u>		<u>0-27</u>
<u>Box 2 SHANNON, Miss</u> (Address)	<u>Blue clay</u>		<u>27-220</u>
(2) Location: <u>1/4, 1/4, Sec. 5 T. 81 R. 66</u>	<u>sand</u>		<u>220-340</u>
<u>2 miles NE</u> of <u>SHANNON</u> (distance) (direction) (Nearest Town)	<u>Bottom</u>		<u>340</u>
(3) Topography: <u>Flat</u> (Hilly) (Flat) (Level)			
(4) Purpose of Well: <u>Domestic</u> (Domestic Irrigation Municipal, Industrial, Other)			

Information upon completion of well:

- (1) Diameter 4 inches.
- (2) Total Depth 340 feet, 84.8 3/2 1/67.
- (3) Water Level 80 feet below top of ground.
- (4) Cased to 29'6", Size 4"
- (5) Screen: Size , Length .
- (6) Were any formations sealed against pollution?
 yes, no.
- If YES depth of formation 27'
- Why surface & sand
- Drillers Remarks: Get 1/2 R.P.

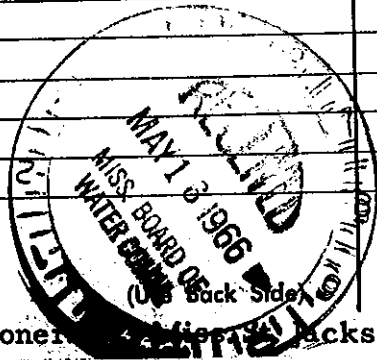

306 ELEV 280

Well No.

Mail this copy to Board of Water Commissioners, Jackson, Miss.