

MISSISSIPPI BOARD OF WATER COMMISSIONERS

LEE
 35
 11-29-63

WATER WELL DRILLERS LOG

HERNDON WELL & SUPPLY CO.

Date: Nov. 29, 1963, Driller: P. O. BOX 42 County Lee

MEMPHIS, MISSISSIPPI

85
 18
 75

(1) Owner of Land:	Description & Color of Materials Sand, Clay, Red Clay, Shell, etc.	Thick- ness Feet	Depth Feet
(Name) <u>E. C. Jackson</u> (Address) <u>Nettleton, Miss.</u>	<u>surface sand & clay</u>		<u>0</u>
(2) Location: <u>1/4, 1/4, Sec 13 T 11 S R 6 E</u> <u>2 1/2 miles North</u> , of <u>Nettleton</u> (distance) (direction) (Nearest Town)	<u>Blue silt</u> <u>sand</u>		<u>33</u> <u>120</u>
(3) Topography: <u>Flat</u> (Hilly) (Flat) (Level)			
(4) Purpose of Well: <u>Domestic</u> (Domestic Irrigation Municipal, Industrial, Other)	<u>Bottom</u>		<u>240</u>

Information upon completion of well:


- (1) Diameter 4 inches.
- (2) Total Depth 240 feet.
- (3) Water Level 80 feet below top of ground.
- (4) Cased to 36' 3", Size 4"
- (5) Screen: Size _____, Length _____
- (6) Were any formations sealed against pollution?
 yes, _____ no.

If YES depth of formation 33 ft

Why surface & sand

Drillers Remarks:

301 ELEV 298

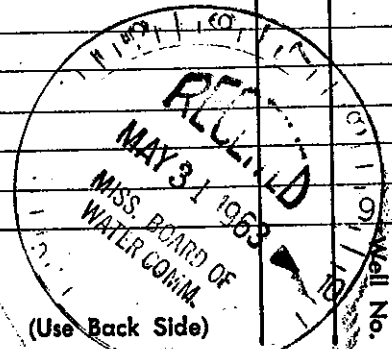

(Use Back Side)

Mail this copy to Board of Water Commissioners 429 Miss. St. Jackson, Miss.