

LEE  
D36

WATER DRILLERS LOG

Herndon Well & Supply Co.

SHANNON, MISS.

County Lee

Date: 2/15/61, 1961, Driller:

GENE KELLY (1967)

(Name)

(1) Owner of Land: Hugh A. Tate

(Name)

Rt 2 SHANNON, MISS.

(Address)

(2) Location: 1/4, 1/4, Sec. 4 T11 S R6 E

3 miles NE of SHANNON

(distance)

(direction)

(Nearest Town)

(3) Topography: Flat

(Hilly)

(Flat)

(Level)

(4) Purpose of Well: Home Use

(Domestic Irrigation  
Municipal, Industrial, Other)

Description & Color of Materials  
Sand, Clay, Red Clay, Shell, etc.

Thick-  
ness  
Feet

Depth  
Feet

clay  
Blk - Rock  
Rock  
Blue Rock  
SAND  
Bottom

26  
76  
86  
195  
320

Information upon completion of well:

(1) Diameter 4 inches.

(2) Total Depth 320 feet.

(3) Water Level 55 feet below top of ground.

(4) Cased to 291, Size 4"

(5) Screen: Size \_\_\_\_\_, Length \_\_\_\_\_

(6) Were any formations sealed against pollution?



yes, no.

If YES depth of formation 25 ft.

Why Surface & Sand

Drillers Remarks:

269 ELEV 278

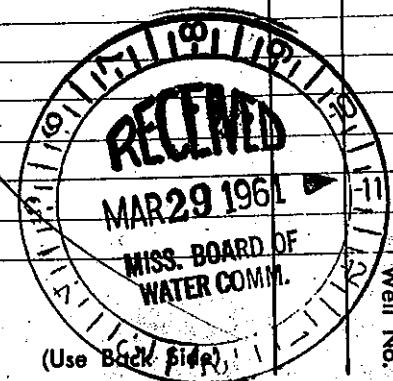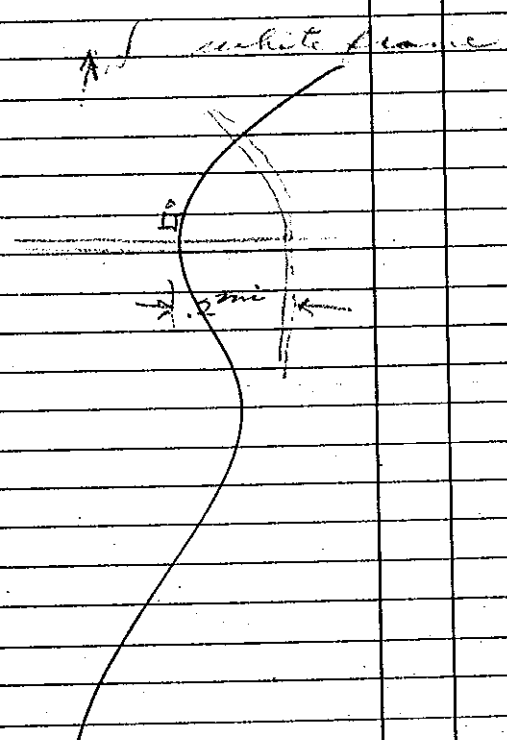

Well No.

(Use Back Side)

Mail this copy to Board of Water Commissioners 429 Miss. St. Jackson, Miss