

LEE
 038
 9-4-61

MISSISSIPPI BOARD OF WATER COMMISSIONERS

WATER WELL DRILLERS LOG
 HERNDON WELL & SUPPLY CO.

0308


P. O. BOX 42

Date: Sept 4, 1961, Driller: SHANNON, MISSISSIPPI County Lee
 (Name)


	Description & Color of Materials Sand, Clay, Red Clay, Shell, etc.	Thick- ness Feet	Depth Feet
(1) Owner of Land: <u>Sam Edwards</u> (Name) <u>Nettleson, Miss.</u> (Address)	<u>Surface mud & clay</u>		<u>0</u>
(2) Location: <u>1/4</u> , <u>1/4</u> , Sec <u>13</u> T. <u>115</u> R. <u>11</u>	<u>Blue rock</u>		<u>30</u>
<u>3</u> miles <u>North</u> , of <u>Nettleson</u> (distance) (direction) (Nearest Town)	<u>Sand</u>		<u>100</u>
(3) Topography: <u>Flat</u> (Hilly) (Flat) (Level)	<u>8</u>		
(4) Purpose of Well: <u>Domestic</u> (Domestic Irrigation Municipal, Industrial, Other)	<u>Bottom</u>		<u>220</u>

Information upon completion of well:

- (1) Diameter 4 inches.
- (2) Total Depth 220 feet.
- (3) Water Level 70 feet below top of ground.
- (4) Cased to 32', Size 4".
- (5) Screen: Size , Length .
- (6) Were any formations sealed against pollution?
 yes, no.

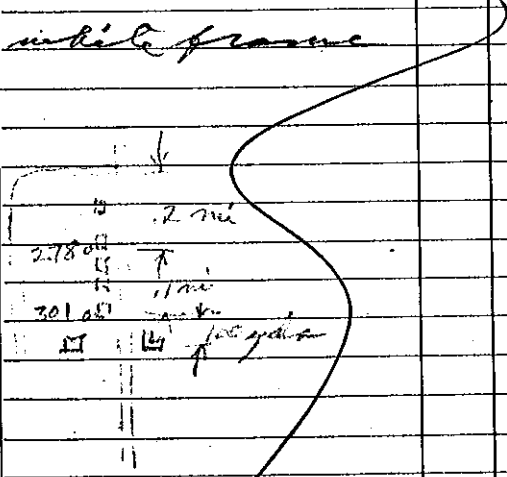

If YES depth of formation 30 ft.
 Why Surface & sand
 Drillers Remarks: _____

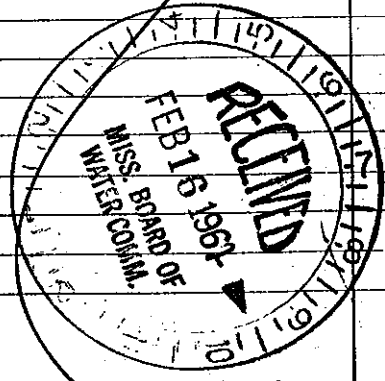

(Use Back Side)

Well No.

278 ELEV 300